SITE NUMBER: SD06798A

SITE NAME: TIERRASANTA ADVENTIST

ADDRESS: 11260 CLAIREMONT MESA BOULEVARD

SAN DIEGO, CA 92124

JURISDICTION: CITY OF SAN DIEGO

PROJECT: CUP

SCOPE OF WORK

T-MOBILE PROPOSES TO:

- RELOCATE (3) EXISTING T-MOBILE PANEL ANTENNAS
- RELOCATE (1) EXISTING T-MOBILE RADIO (RRUS11_B12)
- RELOCATE (1) EXISTING T-MOBILE TMA
- INSTALL (1) NEW T-MOBILE ANTENNA MOUNT INSTALL (1) NEW T-MOBILE ANTENNA MOUNTING PIPE
- INSTALL (3) NEW FRP SCREEN BOXES
- INSTALL (1) NEW 6601 IN EXISTING CABINET
- INSTALL (1) NEW XMU03
- NO NEW BATTERIES TO BE ADDED
- PROJECT VALUATION: \$50,000

DRIVING DIRECTIONS

DIRECTIONS FROM 10509 VISTA SORRENTO PKWY, SAN DIEGO, CA 92121:

- 1. HEAD SOUTHEAST ON VISTA SORRENTO 7. TAKE EXIT 7 FOR I-15 S 8. KEEP RIGHT TO CONTINUE ON EXIT 11,
- SLIGHT RIGHT ONTO THE INTERSTATE 805 SRAMP
- MERGE ONTO I-805 S
- KEEP LEFT AT THE FORK, FOLLOW SIGNS FOR STATE 52 F AND MERGE ONTO CA-52 E/STATE 52 E
- TURN RIGHT ONTO SORRENTO VALLEY RD FOLLOW SIGNS FOR CLAIREMONT MESA BOULEVARD 9. TO TURN LEFT ONTO CLAIREMONT MESA
- BLVD 5. USE THE RIGHT 2 LANES TO TAKE EXIT 23 10. MAKE A U-TURN AT VIA VALARTA

 - DESTINATION WILL BE ON THE RIGHT: 11260 CLAIREMONT MESA BOULEVARD SAN DIEGO, CA 92124

GENERAL NOTES

THE FACILITY IS UNMANNED AND NOT FOR HUMAN HABITATION. A TECHNICIAN WILL VISIT THE SITE AS REQUIRED FOR ROUTINE MAINTENANCE. THE PROJECT WILL NOT RESULT IN ANY SIGNIFICANT DISTURBANCE OR EFFECT ON DRAINAGE: NO SANITARY SEWER SERVICE REQUIRED AND NO COMMERCIAL SIGNAGE IS PROPOSED.

DO NOT SCALE DRAWINGS

CONTRACTOR SHALL VERIFY ALL PLANS, EXISTING DIMENSIONS & FIELD CONDITIONS ON THE JOB SITE & SHALL IMMEDIATELY NOTIFY THE ARCHITECT OR ENGINEER OF RECORD IN WRITING OF ANY DISCREPANCIES BEFORE PROCEEDING WITH THE WORK OR BE RESPONSIBLE FOR THE SAME.

SPECIAL NOTES

- ALL WORK SHALL BE INSTALLED IN CONFORMANCE WITH CURRENT T-MOBILE CONSTRUCTION INSTALLATION GUIDE.
- EXISTING CONDITIONS WILL BE VERIFIED IN FIELD. IF SIGNIFICANT DEVIATIONS OR DETERIORATION ARE ENCOUNTERED AT THE TIME OF CONSTRUCTION, A REPAIR PERMIT WILL BE OBTAINED &
- CONTRACTOR SHALL NOTIFY ARCHITECT OR ENGINEER OF RECORD IMMEDIATELY. CONTRACTOR SHALL VERIFY ALL PLANS & **EXISTING DIMENSIONS & CONDITIONS ON** THE JOB SITE & SHALL IMMEDIATELY

NOTIFY THE ARCHITECT OR ENGINEER OF

- RECORD IN WRITING OF ANY DISCREPANCIES BEFORE PROCEEDING WITH THE WORK OR BE RESPONSIBLE FOR THE SAME
- THESE DRAWINGS ARE FULL SIZE & SCALEABLE ON 22"X34" SHEET SIZE & ARE NOT REDUCED IN SIZE. STATEMENT THAT COMPLIANCE WITH THE OF WORK DOES NOT INVOLVE
- ENERGY CODE IS NOT REQUIRED. -SCOPE MODIFICATIONS TO EXTERIOR ENVELOPE OF BUILDING, HVAC SYSTEMS OF ELECTRICAL LIGHTING.

DESCRIPTION SHEET T-1.0 TITLE SHEET **GENERAL NOTES** T-2.0 ABBREVIATIONS, LEGAL DESCRIPTION, REFERENCED DOCUMENTS T-3.0 LEGEND & SIGNAGE T-4.0 LETTER OF AUTHORIZATION 🖄 A-1.0 OVERALL SITE PLAN EXISTING ENLARGED SITE PLAN A-2.0 PROPOSED ENLARGED SITE PLAN A-2 1 A-3.0 EXISTING & PROPOSED ANTENNA PLANS A-3.1 ANTENNA & RADIO MOUNTING DETAILS (BETA SECTOR) EQUIPMENT PLANS, EXISTING BATTERY CALCULATIONS & A-3.2 ANTENNA SCHEDULE

DRAWING INDEX

NOT FOR CONSTRUCTION UNLESS APPROVED BY JURISDICTION

SCHEMATIC GROUNDING PLANS, NOTES & DETAILS

EXISTING & PROPOSED NORTHWEST ELEVATIONS

EXISTING & PROPOSED NORTHEAST ELEVATIONS

EXISTING & PROPOSED SOUTHEAST ELEVATIONS

EXISTING & PROPOSED SOUTHWEST ELEVATIONS

EQUIPMENT DETAILS & SPECIFICATIONS

EQUIPMENT DETAILS & SPECIFICATIONS

STRUCTURAL DETAILS

CODE COMPLIANCE

2016 CALIFORNIA ENERGY CODE

A-4.0

A-4.1

A-4.2

A-4.3

A-5.0

A-6.0

S-1.0

G-1.0

- 2016 CALIFORNIA BUILDING CODE
- 2016 CALIFORNIA ELECTRICAL CODE
- 2016 CALIFORNIA FIRE CODE 2016 CALIFORNIA MECHANICAL CODE
- 2016 CALIFORNIA PLUMBING CODE


APPROVALS


THE FOLLOWING PARTIES HEREBY APPROVE AND ACCEPT THESE DOCUMENTS & AUTHORIZE THE SUBCONTRACTOR TO PROCEED WITH THE CONSTRUCTION DESCRIBED HEREIN. ALL DOCUMENTS ARE SUBJECT TO REVIEW BY THE LOCAL BUILDING DEPARTMENT & MAY IMPOSE CHANGES OR MODIFICATIONS

| T-MOBILE PROJECT MANAGER: | DATE: |
|--------------------------------|-------|
| T-MOBILE CONSTRUCTION MANAGER: | DATE: |
| T-MOBILE RF ENGINEER: | DATE: |
| T-MOBILE FOPS: | DATE: |
| SITE ACQUISITION: | DATE: |
| PROPERTY OWNER; | DATE: |
| ZONING: | DATE: |





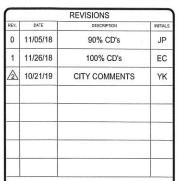

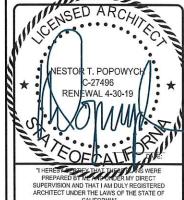


TIERRASANTA ADVENTIST 11260 CLAIREMONT MESA BOULEVARD SAN DIEGO, CA 92124


SHEET TITLE

TITLE SHEET

SHEET NUMBER

T-1.0

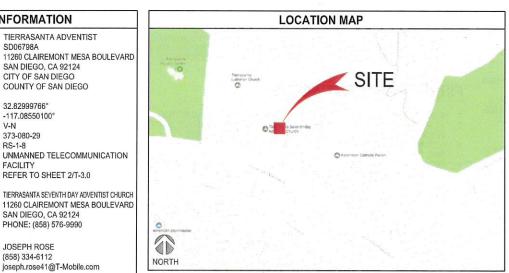

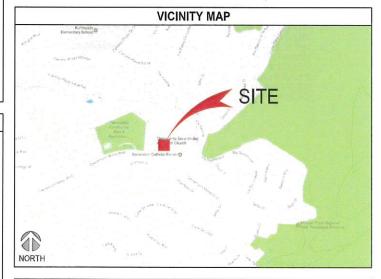



TOLL FREE: 1-800-227-2600 OR www.digalert.org

TO OBTAIN LOCATION OF PARTICIPANTS UNDERGROUND FACILITIES BEFORE YOU DIG IN CALIFORNIA (SOUTH), CALL DIG ALERT

CALIFORNIA STATUTE REQUIRES MIN OF 2 WORKING DAYS NOTICE BEFORE YOU EXCAVATE

REV1.0 Q:\STELE\\$T-MOBILE PROJECTS\SAN DIEGO SITES\SD06798A (L600, L700 & CUP)\2 - CUP PROJECT\CUP_CD'S\TMO_CUP_SD06798A_CD.DWG - 2018-07-24 - YKhaychuk

PLANNING/ZONING CONSULTANT:

SAC WIRELESS

SAC WIRELESS

DAIL RICHARD 5015 SHOREHAM PLACE, STE 150 SAN DIEGO, CA 92122 PHONE: (858) 200-6541 EMAIL: dail.richard@sacw.com

T-MOBILE USA EMILIO MARIO VALERIO-HERNANDEZ, P.E. MUSTAFA AJMAL 5015 SHOREHAM PLACE, STE 150 10509 VISTA SORRENTO PKWY STE 206 SAN DIEGO, CA 92121

RF ENGINEER

PROJECT INFORMATION

SD06798A

32 82999766°

373-080-29

RS-1-8

FACILITY

-117.08550100°

TIERRASANTA ADVENTIST

SAN DIEGO, CA 92124

COUNTY OF SAN DIEGO

REFER TO SHEET 2/T-3.0

SAN DIEGO, CA 92124

PHONE: (858) 576-9990

joseph.rose41@T-Mobile.com

CONSTRUCTION MANAGER:

(858) 334-6112

DAIL RICHARD

(858) 200-6541

PROJECT TEAM

5015 SHOREHAM PLACE, STE 150 10509 VISTA SORRENTO PKWY

SAC WIRELESS ON

BEHALF OF T-MOBILE

dail richard@sacw.com

T-MOBILE USA

KIRT BABCOCK

SAN DIEGO, CA 92121

PHONE: (858) 334-6139

EMAIL: kirt.babcock@T-Mobile.com

STF 206

SITE NAME:

SITE NUMBER

SITE ADDRESS:

JURISDICTION:

COUNTY:

LATITUDE:

LONGITUDE:

PROPOSED USE:

CONSTRUCTION TYPE:

LEGAL DESCRIPTION:

PROPERTY OWNER:

APPLICANT:

ARCHITECT: SAC WIRELESS

NESTOR POPOWYCH, A.I.A.

CONTACT: DENNIS YOSHII

PHONE: (619) 736-3766 X105

EMAIL: dennis.voshii@sacw.com

SAN DIEGO CA 92122

ZONING CLASSIFICATION:

T-MOBILE PROJECT MANAGER: JOSEPH ROSE

SAN DIEGO, CA 92122 PHONE: (619) 736-3766 X114

PHONE: -EMAIL: emilio.hernandez@sacw.com EMAIL: mustafa.aimal@T-Mobile.co

GENERAL NOTES:

- THIS FACILITY IS EXEMPT FROM ACCESSIBILITY REQUIREMENTS PER CALIFORNIA/INTERNATIONAL BUILDING CODE SECTION 11B-203.5. THIS FACILITY IS NON-OCCUPIABLE SPACE AND ENTERED ONLY BY SERVICE PERSONNEL.
- 2. ALL WORK SHALL CONFORM TO THE REQUIREMENTS OF THE LOCAL BUILDING CODE, THE LATEST EDITION AND ALL OTHER APPLICABLE CODES AND ORDINANCES.
- 3. CONTRACTOR SHALL CONSTRUCT SITE IN ACCORDANCE WITH THESE DRAWINGS AND CONSTRUCTION SPECIFICATIONS. THE SPECIFICATION IS THE RULING DOCUMENT AND ANY DISCREPANCIES BETWEEN THE SPECIFICATION AND THESE DRAWINGS SHOULD BE BROUGHT TO THE ATTENTION OF THE ARCHITECT OR ENGINEER OF RECORD PRIOR TO PROCEEDING WITH CONSTRUCTION.
- CONTRACTOR SHALL VISIT THE JOB SITE AND SHALL FAMILIARIZE HIMSELF WITH ALL CONDITIONS AFFECTING THE PROPOSED WORK AND SHALL MAKE PREVISIONS AS TO THE COST THEREOF, CONTRACTOR SHALL BE RESPONSIBLE FOR FAMILIARIZING HIMSELF WITH ALL CONTRACT DOCUMENTS, FIELD CONDITIONS AND DIMENSIONS AND CONFORMING THAT THE WORK MAY BE ACCOMPLISH AS SHOWN PRIOR TO PROCEEDING WITH CONSTRUCTION, ANY DISCREPANCIES SHALL BE BROUGHT TO THE ATTENTION OF THE ARCHITECT OR ENGINEER OF RECORD PRIOR TO THE COMMENCEMENT OF WORK. NO COMPENSATION WILL BE AWARDED BASED ON CLAIM OF LACK OF KNOWLEDGE OF FIELD CONDITIONS.
- PLANS ARE NOT TO BE SCALED. THESE PLANS ARE INTENDED TO BE A DIAGRAMMATIC OUTLINE ONLY UNLESS. OTHERWISE NOTED. THE WORK SHALL INCLUDE FURNISHING MATERIALS, EQUIPMENT AND APPURTENANCES, AND LABOR NECESSARY TO EFFECT ALL INSTALLATIONS AS INDICATED ON THE DRAWINGS, OWNER PROVIDED MATERIALS WILL INCLUDE THE FOLLOWING, UNLESS NOTED OTHERWISE:
- TRANSMITTER
- RF FILTER
- MFTS RACKS
- AUXILIARY EQUIPMENT IN MFTS RACK PUMP ASSEMBLY
- HEAT EXCHANGE
- HOSE AND HOSE MANIFOLD (ANY COPPER OR STEEL SECTION PROVIDED BY CONTRACTOR)
- UHF ANTENNA AND MOUNTING BRACKET, GPS ANTENNA AND KU ANTENNAS
- UHF COAX AND HANGERS
- 480-208 & 208-400 ELECTRICAL TRANSFORMER
- AUTOMATIC TRANSFER SWITCH AND GENERATOR
- EQUIPMENT SHELTER (SHELTER FURNISH IN FACTORY W/HVAC EQUIPMENT AND ELECTRICAL DISTRIBUTION PANEL)
- INTEGRATED LOAD CENTER
- ANTENNAS RADIOS & CABLES
- DIMENSIONS SHOWN ARE TO FINISH SURFACES UNLESS OTHERWISE NOTED, SPACING BETWEEN EQUIPMENT IS REQUIRED CLEARANCE. THEREFORE, IT IS CRITICAL TO FIELD VERIFY DIMENSIONS, SHOULD THERE BE ANY QUESTIONS REGARDING THE CONTRACT DOCUMENTS, EXISTING CONDITIONS AND/OR DESIGN INTENT, THE CONTRACTOR SHALL BE RESPONSIBLE FOR OBTAINING THE WORK
- DETAILS ARE INTENDED TO SHOW DESIGN INTENT. MODIFICATIONS MAY BE REQUIRED TO SUIT JOB DIMENSIONS OR CONDITIONS AND SLICH MODIFICATIONS SHALL BE INCLUDED AS PART OF THE WORK
- CONTRACTOR SHALL RECEIVE CLARIFICATION IN WRITING, AND SHALL RECEIVE IN WRITING AUTHORIZATION TO PROCEED BEFORE STARTING WORK ON ANY ITEMS NOT CLEARLY DEFINED OR IDENTIFIED BY THE CONTRACT DOCUMENT
- CONTRACTOR SHALL SUPERVISE AND DIRECT THE WORK USING THE BEST CONSTRUCTION SKILLS AND ATTENTION CONTRACTOR SHALL BE SOLELY RESPONSIBLE FOR CONSTRUCTION MEANS METHODS TECHNIQUES, SEQUENCES AND PROCEDURES AND FOR COORDINATING ALL PORTIONS OF THE WORK UNDER CONTRACT, UNLESS OTHERWISE NOTED.
- 10. CONTRACTOR SHALL BE RESPONSIBLE FOR THE SAFETY OF THE WORK AREA, ADJACENT AREAS AND BUILDING OCCUPANTS THAT ARE LIKELY TO BE AFFECTED BY THE WORK UNDER THIS CONTRACT, WORK SHALL CONFORM TO ALL OSHA REQUIREMENTS.
- CONTRACTOR SHALL COORDINATE HIS WORK WITH THE SUPERINTENDENT OF THE BUILDING & GROUNDS & SCHEDULE HIS ACTIVITIES AND WORKING HOURS IN ACCORDANCE WITH THE REQUIREMENTS.
- 12. CONTRACTOR SHALL BE RESPONSIBLE FOR COORDINATING HIS WORK WITH THE WORK OF OTHERS AS IT MAY RELATE TO RADIO EQUIPMENT, ANTENNAS AND ANY OTHER PORTIONS OF THE WORK.
- 13. INSTALL ALL EQUIPMENT AND MATERIAL IN ACCORDANCE WITH MANUFACTURER'S RECOMMENDATIONS UNLESS SPECIFICALLY OTHERWISE INDICATED OR WHERE LOCAL CODES OR REGULATIONS TAKE
- 14. MAKE NECESSARY PROVISIONS TO PROTECT EXISTING SURFACE, EQUIPMENT, IMPROVEMENTS, PIPING, ETC.
- AND IMMEDIATELY REPAIR ANY DAMAGE THAT OCCURS DURING CONSTRUCTION.

 15. IN DRILLING HOLES INTO CONCRETE WHETHER FOR FASTENING OR ANCHORING PURPOSES, OR PENETRATIONS THROUGH THE FLOOR FOR CONDUIT RUNS, PIPE RUNS, ETC., IT MUST BE CLEARLY UNDERSTOOD THAT REINFORCING STEEL SHALL NOT BE DRILLED INTO, CUT OR DAMAGED UNDER ANY CIRCUMSTANCES (UNLESS NOTED OTHERWISE). LOCATIONS OF REINFORCING STEEL ARE NOT DEFINITELY KNOWN AND THEREFORE MUST BE SEARCHED FOR BY APPROPRIATE METHODS AND FOUIPMENT
- 16. REPAIR ALL EXISTING WALL SURFACE DAMAGED DURING CONSTRUCTION SUCH THAT THEY MATCH AND BLEND IN WITH ADJACENT SURFACE
- SEAL PENETRATION THROUGH FIRE RATED AREAS WITH U.L. LISTED AND FIRE CODE APPROVED MATERIALS.
- 18. KEEP CONTRACT AREA CLEAN, HAZARD FREE, AND DISPOSE OF ALL DIRT, DEBRIS, AND RUBBISH. EQUIPMENT NOT SPECIFIED AS REMAINING ON THE PROPERTY OF THE OWNER SHALL BE REMOVED. LEAVE PREMISES IN
- CLEAN CONDITIONS AND FREE FROM PAINT SPOT, DUST, OR SMUDGES OF ANY NATURE, CONTRACTOR SHALL BE RESPONSIBLE FOR MAINTAINING ALL ITEMS UNTIL COMPLETION OF CONSTRUCTION. 19. MINIMUM BEND RADIUS OF ANTENNA CABLE SHALL BE IN ACCORDANCE WITH CABLE MANUFACTURER'S
- 20. DAMAGE TO EXISTING STRUCTURES AND/OR UTILITIES RESULTING FROM CONTRACTORS NEGLIGENCE SHALL BE REPAIRED AND/OR REPLACED TO THE OWNERS SATISFACTION AT NO ADDITIONAL COST TO THE CONTRACT.
- 21. ALL CONSTRUCTION IS TO ADHERE TO T-MOBILE'S INTEGRATED CONSTRUCTION STANDARDS UNLESS CALIFORNIA CODE IS MORE STRINGENT
- 22. THE INTENT OF THE PLANS AND SPECIFICATIONS IS TO PERFORM THE CONSTRUCTION IN ACCORDANCE WITH THE CALIFORNIA BUILDING STANDARDS CODE (IF APPLICABLE, TITLE 19 AND 24 CALIFORNIA CODE REGULATIONS), SHOULD ANY CONDITIONS DEVELOP NOT COVERED BY THE APPROVED PLANS AND SPECIFICATIONS WHEREIN THE FINISH WORK WILL NOT COMPLY WITH THE REFERENCED CODE ON SHEET T-1.0, A CHANGE ORDER DETAILING AND SPECIFYING THE REQUIRED WORK SHALL BE SUBMITTED TO AND APPROVED BY THE JURISDICTION BEFORE PROCEEDING WITH THE WORK.

SITE WORK NOTES:

RECOMMENDATIONS.

- DO NOT SCALE BUILDING DIMENSIONS FROM DRAWINGS.
- SIZE, LOCATION, AND TYPE OF ANY UNDERGROUND UTILITIES OR IMPROVEMENTS SHALL BE ACCURATELY NOTED AND PLACED ON AS-BUILT DRAWINGS BY GENERAL CONTRACTOR AND ISSUED TO ARCHITECT OR ENGINEER OF RECORD AT COMPLETION OF PROJECT.
- ALL EXISTING UTILITIES, FACILITIES, CONDITIONS AND THEIR DIMENSIONS SHOWN ON PLANS HAVE BEEN

PLOTTED FROM AVAILABLE RECORDS. THE ARCHITECT OR ENGINEER OF RECORD AND OWNER ASSUME NO RESPONSIBILITY WHATSOEVER AS TO THE SUFFICIENCY OR ACCURACY OF THE INFORMATION SHOWN ON THE PLANS OR THE MANNER OF THEIR REMOVAL OR ADJUSTMENT, CONTRACTOR SHALL BE RESPONSIBLE FOR DETERMINING EXACT LOCATION OF ALL EXISTING UTILITIES AND FACILITIES PRIOR TO START OF CONSTRUCTION. CONTRACTOR SHALL ALSO OBTAIN FROM EACH UTILITY COMPANY DETAILED INFORMATION RELATIVE TO WORK SCHEDULES AND METHODS OF REMOVING OR ADJUSTING EXISTING UTILITIES.

- CONTRACTOR SHALL VERIFY ALL EXISTING UTILITIES BOTH HORIZONTAL AND VERTICALLY PRIOR TO START OF CONSTRUCTION. ANY DISCREPANCIES OR DOUBTS AS TO THE INTERPRETATION OF PLANS SHALL BE IMMEDIATELY REPORTED TO THE ARCHITECT OR ENGINEER OF RECORD FOR RESOLUTION AND INSTRUCTION, AND NO FURTHER WORK SHALL BE PERFORMED UNTIL THE DISCREPANCY IS CHECKED AND CORRECTED BY THE ARCHITECT OR ENGINEER OF RECORD. FAILURE TO SECURE SUCH INSTRUCTION MEANS CONTRACTOR WILL HAVE WORKED AT HIS/HER OWN RISK AND EXPENSE. CONTRACTOR SHALL CALL LOCAL DIGGER HOT LINE FOR UTILITY LOCATIONS 48 HOURS PRIOR TO START OF CONSTRUCTION.
- CONTRACTOR SHALL CLEAN ENTIRE SITE AFTER CONSTRUCTION SUCH THAT NO PAPER, TRASH, WEEDS, BRUSH OR ANY OTHER DEPOSITS WILL REMAIN. ALL MATERIALS COLLECTED DURING CLEANING OPERATIONS SHALL BE DISPOSED OF OFF-SITE BY THE GENERAL CONTRACTOR.
- ALL SITE WORK SHALL BE CAREFULLY COORDINATED BY THE GENERAL CONTRACTOR WITH LOCAL UTILITY COMPANY, TELEPHONE COMPANY, AND ANY OTHER UTILITY COMPANIES HAVING JURISDICTION OVER THIS

PAINTING NOTES & SPECIFICATIONS:

A. GENERAL

- ALL PAINT PRODUCT LINES SHALL BE SHERWIN WILLIAMS UNLESS SPECIFICALLY NOTED OTHERWISE.
- CONTRACTOR SHALL PREPARE ALL SURFACES AND APPLY ALL FINISHES PER LATEST EDITION OF MANUFACTURER'S SPECIFICATIONS
- COMPLY WITH MANUFACTURER'S WRITTEN INSTRUCTIONS REGARDING SUFFICIENT DRYING TIME BETWEEN COATS WITH PROVISIONS AS RECOMMENDED BY MANUFACTURER FOR EXISTING WEATHER CONDITIONS.
- FINISH COLOR AND TEXTURE OF ALL PAINTED SURFACES SHALL MATCH EXISTING ADJACENT SURFACES UNLESS OTHERWISE NOTED.
- ALL PAINT MATERIAL DATA SHEETS SHALL BE PROVIDED TO THE T-MOBILE CONSTRUCTION MANAGER.
- PREPARE PREVIOUSLY PAINTED SURFACE BY LIGHT SANDING WITH 400 GRIT SANDPAPER AND NON-HYDROCARBON WASH, PREPARE GALVANIZED SURFACES BY ACID ETCH OR SOLVENT CLEANING IN ACCORDANCE WITH SSPC-SP1
- FURNISH DROP CLOTHES, SHIELDS, MASKING AND PROTECTIVE METHODS TO PREVENT SPRAY OR DROPPINGS FROM DAMAGING ADJACENT SURFACES AND FACILITIES.
- APPLY PAINT BY AIRLESS SPRAY, SANDING LIGHTLY BETWEEN EACH SUCCEEDING ENAMEL COAT ON FLAT SURFACES, APPLY MATERIAL TO ACHIEVE A COATING NO THINNER THAN THE DRY FILM THICKNESS INDICATED.
- APPLY BLOCK FILTER TO CONCRETE BLOCK CONSTRUCTION AT A RATE TO ENSURE COMPLETE COVERAGE WITH PORES COMPLETELY FILLED.
- CONTRACTOR SHALL CORRECT RUNS, SAGS, MISSES AND OTHER DEFECTS INCLUDING INADEQUATE COVERAGE AS DIRECTED BY THE T-MOBILE CONSTRUCTION MANAGER. REPAINT AS NECESSARY TO ACHIEVE SURFACES WHICH ARE SMOOTH, EVENLY COATED WITH UNIFORM SHEEN AND FREE FROM BLEMISHES.

B. COATING SYSTEM SPECIFICATIONS

- DTM ACRYLIC COATING (SERIES B66) BY SHERWIN WILLIAMS CO. 1MIL DFT PER COAT APPLIED IN TWO COATS OVER DTM BONDING PRIMER (B66A50).
- 100% ACRYLIC, LATEX COATING EQUIVALENT TO A-100 (SERIES A-82) BY SHERWIN WILLIAMS CO. 1 DFT PER COAT APPLIED IN TWO COATS OVER SPECIFIED PRIMER PAINT & PRIMER

ANTENNAS

PRIMER - KEM AQUA E61-W525

TOPCOAT - COROTHANE II B65W200/B60V22

BTS CABINET

PRIMER - KEM AQUA F61-W525

TOPCOAT - COROTHANE II B65W200/B60V22

COAXIAL JUMPER CABLES

PRIMER - AS REQUIRED FOR ADHESION. APPLY ONE COAT OF KEM AQUA WATER REDUCIBLE PRIMER E61W25 REDUCED 25%

TOPCOAT - 2 COATS COROTHANE II POLYURETHANE B65W200/B60V2

PRIMER - KEM BOND HS B50WZ4, DMT ACRYLIC PRIMER TOPCOAT - 2 COATS COROTHANE II POLYURETHANE B65W200/B60V2

ACID ETCH WITH COMMERCIAL ETCH OR VINEGAR PRIMER COAT AND FINISH COAT (GALVITE HIGH SOLIDS OR DTM PRIMER/FINISH)

STAINLESS STEEL

PRIMER - OTM WASH PRIMER B71Y1

TOPCOATS - 2 COATS COROTHANE II POLYURETHANE B65W200/B60V2

PRE-PRIMED STEEL

TOUCH UP ANY RUST OR UN-PRIMED STEEL WITH KEM BOND HS, SS0WZ4

ALLIMINUM & COPPER

PRIMER - DTM WASH PRIMER, B71Y1

TOPCOAT - 2 COATS COROTHANE II POLYURETHANE B65W200/B60V2

CONCRETE MASONRY PRIMER - PRO MAR EXTERIOR BLOCK FILLER

TOPCOAT - 2 COATS A-100 LATEX HOUSE & TRIM, SHEEN TO MATCH

CONCRETE STUCCO (EXISTING)

2 COATS A-100 LATEX HOUSE & TRIM, SHEEN TO MATCH

PRIMER - PRO MAR MASONRY CONDITIONED B-46 W21000 TOPCOAT - SUPERPAINT A-80 SERIES A-89 SATIN A-84 GLOSS

PRIMER - A-100 EXTERIOR ALKYD W009D PRIMER Y-24W20 TOPCOAT - 2 COATS A-100 LATEX HOUSE & TRIM SHEEN TO MATCH ADJACENT SURFACES FIELD CUTS/ DAMAGE (PRIOR TO PRIME & PAINT)

FIRST & SECOND COAT - CUPRINOL CLEAR WOOD PRESERVATIVE #158-0356 ALL PENETRATIONS INTO FINISHED GLU-LAMS SHALL BE CAULKED WITH "SIKAFLEX" SEALANT STEEL TOUCH UP

STEEL THAT HAS BEEN WELDED, CUT OR SCRATCHED IN THE FIELD SHALL BE TOUCHED UP WITH COLD GALVANIZED PAINT

GROUNDING NOTES:

- COMPRESSION CONNECTIONS (2), 2 AWG BARE TINNED SOLID COPPER CONDUCTORS TO GROUNDING BAR. ROUTE CONDUCTORS TO BURIED GROUNDING RING AND PROVIDE PARALLEL EXOTHERMIC WELD.
- EC SHALL USE PERMANENT MARKER TO DRAW THE LINES BETWEEN EACH SECTION AND LABEL EACH SECTION ("P", "A", "N", "I") WITH 1" HIGH LETTERS
- ALL HARDWARE 18-8 STAINLESS STEEL, INCLUDING LOCK WASHERS, COAT ALL SURFACES WITH AN ANTI-OXIDANT COMPOUND BEFORE MATING. ALL HARDWARE SHALL BE STAINLESS STEEL 3/8 INCH DIAMETER ORLARGER
- 4. FOR GROUND BOND TO STEEL ONLY: INSERT A CADMIUM FLAT WASHER BETWEEN LUG AND STEEL, COAT ALL SURFACES WITH AN ANTI-OXIDANT COMPOUND BEFORE MATING.
- NUT & WASHER SHALL BE PLACED ON THE FRONT SIDE OF THE GROUNDING BAR AND BOLTED ON THE BACK
- NUMBER OF GROUNDING BARS MAY VARY DEPENDING ON THE TYPE OF TOWER, ANTENNA LOCATION, AND CONNECTION ORIENTATION, PROVIDE AS REQUIRED.
- WHEN THE SCOPE OF WORK REQUIRES THE ADDITION OF A GROUNDING BAR TO AN EXISTING TOWER, THE SUBCONTRACTOR SHALL OBTAIN APPROVAL FROM THE TOWER OWNER PRIOR TO MOUNTING THE GROUNDING BAR TO THE TOWER.
- ALL ELECTRICAL AND GROUNDING AT THE CELL SITE SHALL COMPLY WITH THE NATIONAL ELECTRICAL CODE (NEC), NATIONAL FIRE PROTECTION ASSOCIATION (NFPA) 780 (LATEST EDITION), CALIFORNIA BUILDING

BATTERY NOTES:


ANY CHANGES OR ADDITIONS TO BACK-UP BATTERIES SHALL NOT CONTAIN ELECTROLYTE QUANTITIES IN EXCESS OF 50 GALLONS AND NEED NOT COMPLY WITH THE REQUIREMENTS OF CALIFORNIA/INTERNATIONAL FIRE CODE (REFERRED TO IN T-1.0) SECTION 608 AS INDICATED IN SECTION 608.

FIRE DEPARTMENT NOTES:

- IF FIRE DEPARTMENT FINAL INSPECTION IS REQUIRED, SCHEDULE INSPECTION 2 DAYS IN ADVANCE.
- A CALIFORNIA/INTERNATIONAL FIRE CODE PERMIT TO OPERATE BATTERY SYSTEMS WITH STATIONARY LEAD-ACID BATTERIES IS NOT REQUIRED FOR THE QUANTITIES ON SITE.
- A CALIFORNIA/INTERNATIONAL FIRE CODE PERMIT MAY BE REQUIRED FOR THE HAZARDOUS MATERIALS ON REQUIRED SIGNAGE SHALL INCLUDE LETTERING HEIGHT OF AT LEAST ONE INCH, IN A COLOR THAT CONTRASTS
- TO THE SIGN BACKGROUND, AND SHALL BE PROMINENTLY DISPLAYED.
- AN APPROVED METHOD TO NEUTRALIZE SPILLED ELECTROLYTE SHALL BE PROVIDED IN THE BATTERY ROOM. BATTERIES SHALL BE PROVIDED WITH SAFETY VENTING CAPS.
- CONTRACTOR SHALL VERIFY IN FIELD THE EXISTENCE OR INSTALLATION OF A FIRE EXTINGUISHER WITH A MINIMUM RATING OF 2A-10BC, WITH A CHARGE STATUS ACCEPTABLE TO THE LOCAL FIRE AUTHORITY HAVING
- JURISDICTION. LOCATIONS AND CLASSIFICATIONS OF EXTINGUISHERS SHALL BE IN ACCORDANCE WITH THE UNIFORM FIRE CODE STANDARD 10-1 AND PLACEMENT IS SUBJECT TO APPROVAL OF THE FIRE INSPECTOR.
- STORAGE, DISPENSING OR USE OF ANY FLAMMABLE AND COMBUSTIBLE LIQUIDS, FLAMMABLE AND COMPRESSED GASES, AND OTHER HAZARDOUS MATERIALS SHALL COMPLY WITH UNIFORM FIRE CODE REGULATIONS
- 10. EXIT DOORS SHALL BE ABLE TO OPEN FROM THE INSIDE WITHOUT THE USE OF KEY OR ANY SPECIAL KNOWLEDGE OR EFFORT
- ADDRESS NUMBERS SHALL BE A MINIMUM 6 INCHES HIGH AND PLAINLY VISIBLE FROM ROADWAY BUILDING IS ADDRESSED ON. REQUIRED SIGNAGE SHALL INCLUDE, BUT MAY NOT BE LIMITED TO, APPLICABLE TYPES FROM EXAMPLES
- SHOWN HEREIN (SEE SIGNAGE IN T-3.0). ALL PENETRATIONS THROUGH FIRE RATED ASSEMBLIES SHALL BE CONSTRUCTED SO AS TO MAINTAIN AN FOLIAL OR GREATER FIRE RATING
- 14. DECORATIVE MATERIALS SHALL BE MAINTAINED IN A FLAME-RETARDANT CONDITION **ICALIFORNIA/INTERNATIONAL FIRE CODE 807.3**





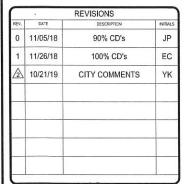



CLIP TIERRASANTA ADVENTIST SD06798A 11260 CLAIREMONT MESA BOULEVARD SAN DIEGO, CA 92124

SHEET TITLE

GENERAL NOTES

SHEET NUMBER

T-2.0





general public exposure limit

In accordance with Federal Communications Commission rules radio frequency emissions 47 CFR 1.1307 (b)



Obedezca todas las señales indicadas y las guias del sillo para trabajar en los ambietes de frecuencia de radio.

CAUTION



this site may exceed FCC rules for human exposure For your safety, obey all posted signs and site guidelines for workin in radio frequency environments.

Radio frequency fields at



A partir de este lugar: Los campos de frecuencias de radio en este sitio podrán exceder el limite del cual las reglas del FCC

or su seguridad, obedezca todas las idicadas y las guias del sitio para tra os amblentes de frecuencia de radio. De acuerdo a las reglas de la Comisión Federal Comunicaciones (FCC) sobre las emisiones de fera-encias de tadio 47 CFR 1.1307(b)



Beyond this point: Radio frequency fields at this site may exceed FCC rules for human exposure Failure to obey all posted signs and site guidelines for working in radio frequency environments could resul in serious injury.





SIGNAGE

A partir de este lugar: .os campos de frecuencias de radio en este sitio exceden Il limite del cual las reglas del

ALERTING SIGNS

A NOTICE A **GUIDELINES FOR WORKING IN**

- RADIOFREQUENCY ENVIRONMENTS ▲ All personnel should have electromagnetic energy (EME)
- awareness training. All personnel entering this site must be authorized.
- A Obey all posted signs.
- Assume all antennas are active. A Before working on antennas, notify owners and disable appropriate
- A Mantain minimum 3 feet clearance from all antennas
- À Do not stop in front of atennas.
 À Use personal RF monitors while working near atennas.
- A Never operate transmitters without shields during normal operation
- A Do not operate base station antennas in equipment room.





THIS FACILITY CONTAINS CORROSIVE LIQUID **TOXIC LIQUID CLASS 1** WATER REACTIVE LIQUID

IN CASE OF **EMERGENCY** CALL

1-888-662-4662 SITE NUMBER: SD06798A

SITE NAME: TIERRASANTA **ADVENTIST**



INFORMATION SIGN

(X) A-X) DETAIL REFERENCE LINE TYPES (X) ELEVATION REFERENCE PROPERTY LINE

CENTER LINE

FIBER CABLE

GROUNDING CABLE

CHAIN LINK FENCE

WOOD FENCE

ELEVATION BUBBLE

AZIMUTH ARROW

MECHANICAL GRND. CONN.

ALPHA @ 30°

CADWELD

00 00 00 00 00

GROUND BUS BAR



EXISTING T-MOBILE PANEL ANTENNAS

EXISTING T-MOBILE RADIO

EXISTING T-MOBILE TMA

LEGEND

CONSTRUCTION DRAWINGS: SD06798A_Permitting_SD06798 BOK - Approved CDs BY MITCHELL J

ARCHITECTURE; 10-02-13 SCOPE OF WORK: RFDS_SD06798A_1.1_L700_Signed_021417

SITE WALK: N/A

BATTERY INFORMATION: SD06798A_Other_SD06798A Site Survey Form_X3

REFERENCED DOCUMENTS

SCALE

SCALE

N.T.S.

PARCEL A

PARCEL 1 PARCEL MAP NO. 15580, IN THE CITY OF SAN DIEGO, COUNTY OF SAN DIEGO, STATE OF CALIFORNIA, FILED IN THE OFFICE OF THE COUNTY RECORDER OF SAN DIEGO COUNTY, FEBRUARY 23, 1989 AS FILE/PAGE NO. 89-092635 OF OFFICIAL RECORDS

PARCEL B

AN EASEMENT FOR INGRESS AND EGRESS OVER, ALONG AND ACROSS THAT PORTION OF LOT 1 OF TIERRASANTA LUTHERAN CHURCH, ACCORDING TO THE MAP THEREOF NO. 10755 IN THE CITY OF SAN DIEGO, COUNTY OF SAN DIEGO, STATE OF CALIFORNIA, FILED IN THE OFFICE OF THE COUNTY RECORDER OF SAN DIEGO COUNTY, NOVEMBER 7, 1983, DESCRIBED AS FOLLOWS:

BEGINNING AT THE SOUTHEASTERLY CORNER OF SAID LOT BEING A POINT ON A 1551.00 FOOT RADIUS CURVE CONCAVE SOUTHWESTERLY. A RADIAL LINE BEARS NORTH 19°24'50" EAST TO SAID POINT; THENCE NORTHWESTERLY ALONG SAID CURVE AND ALONG THE SOUTHERLY LINE OF SAID LOT 1 THROUGH A CENTRAL ANGLE OF 00°35'46" A DISTANCE OF 16.14 FEET TO A POINT ON A NONTANGENT 60.00 FOOT RADIUS CURVE CONCAVE SOUTHEASTERLY, A RADIAL LINE BEARS NORTH 66°15'20" WEST TO SAID POINT THENCE NORTHEASTERLY ALONG SAID CURVE THROUGH A CENTRAL ANGLE OF 43°29'55" A DISTANCE OF 45.55 FEET TO A PORTION ON THE EASTERLY LINE OF SAID LOT 1; THENCE ALONG SAID EASTERLY LINE SOUTH 24°18'25" WEST 40.00 FEET TO THE POINT OF BEGINNING.

ABBREVIATION DEFINITION

A.B.

ABV.

ANT

APX

BCN

BDK

BM

B.N.

RTM

BRC

BTS

B/U

CAR

CPD

C.T.

DEF.

D.F.

DIAG.

DIM.

DR

DWG.

DWL.

EBX

EG

EL.

EGR

ELEV.

E.M.T.

E.O.P.

EQ. (=)

EVLT

ENG.

EXST.

F.O.

FIN.

FLR.

FDN.

F..S.

F..W.

F.S.

FTG.

G.F.I.

GRC

DIAGONAL

DOOR

DIMENSION

DRAWING(S)

DOWEL(S)

ELEVATION

ELECTRICAL

ELEVATOR

EXPANSION

EXISTING

EXTERIOR

FLECTRICAL BOX

EQUIPMENT GROUND

ELECTRICAL METER

EDGE OF PAVEMENT

ELECTRICAL VAULT

FABRICATION(OR)

FINISH FLOOR

FINISH GRADE

FOUNDATION

FACE OF STUD

FACE OF WALL

FOOT(FEET)

GALVANIZE(D)

GENERATOR

FOOTING

GAUGE

FACE OF CONCRETE

FACE OF MASONRY

FINISHED SURFACE

GROUND FAULT INTERRUPTER

GLOBAL POSITIONING SYSTEM

GROWTH RADIO CABINET

FINISH(ED)

FLOOR

EQUIPMENT GROUND RING

ELECTRICAL METALLIC TUBING

BD.

AC

ANCHOR BOLT GRND. GROUND AROVE HDR HEADER AIR CONDITIONING HGR. HEIGHT ACU ISOLATED COPPER GROUND BUS AIR CONDITIONING UNIT ICGB. ANTENNA CABLE COVER ASSY. INTERIOR GROUND RING ACCA ADDITIONAL INCH(ES) ABOVE FINISHED FLOOR A.F.F INTERIOR POUND(S) ABOVE FINISHED GRADE AFG LB. (#) ABOVE GRADE LEVEL LAG BOLTS A.G.L L.B. LINEAR FEET (FOOT) ALUM. ALUMINUM L.F. ALTERNATE LONG(ITUDINAL) MASTER GROUND BUS ANTENNA MGB APPRX. APPROXIMATE(LY) MASONRY MAS. APEX MAX. MAXIMUM ARCHITECT(URAL) MACHINE BOLT ASSY. ASSEMBLY MECH. MECHANICAL AMERICAN WIRE GAUGE AWG MER MANUFACTURER MINIMUM BEACON MIN. BOLLARD MISC. **MISCELLANEOUS BRASS DISK** BUILDING MW MICROWAVE BLOCK BLK. NUMBER BI KG BLOCKING NO. (#) BEAM / BENCH MARK NOT TO SCALE N.T.S. BOUNDARY NAILING O.C. ON CENTER BARE TINNED COPPER WIRE OVERHEAD OVERHEAD POWER LINE B.O.F. BOTTOM OF FOOTING OPNG ROTTOM OPENING PRECAST CONCRETE BRACE BASE TRANSCEIVER STATION PLY. **PLYWOOD** B.W.F BARBED WIRE FENCE POWER PROTECTION CABINET BACK-UP CABINET PSF POLINDS PER SOLIARE FOOT POUNDS PER SQUARE INCH CABINET P.S.I. CANT CANTILEVER(ED) PRESSURE TREATED P.T. POWER (CABINET) C.I.P. CAST IN PLACE PWR. CHAIN LINK FENCE QTY. QUANTITY CLG. CEILING RADIUS RADIATION CENTER CLR. COL. CLEAR RAD CTR RADIO BASE STATION COLUMN RBS CONC CONCRETE REF. REFERENCE CONNECTION(OR) REINFORCEMENT(ING) CONN REINF CONST CONSTRUCTION REQD. REQUIRED RADIO FREQUENCY CONT CONTINUOUS RF RGS RIGID GALVANIZED STEEL CONCRETE PAD REMOTE RADIO UNIT CABLE TRAY RRU REMOTE RADIO HEAD PENNY (NAILS) DOUBLE SCH. SCHEDULE DEFINITION SHT SHEET SIM. SIMILAR DEPARTMENT DEPT DOUGLAS FIR SPEC. SPECIFICATION(S) DIA. (Ø) DIAMETER STEEL PLATE

SQ.

S.S.

STD

STL.

TRR

TEMP.

THK.

T.O.A

T.O.C.

T.O.F

T.O.P.

T.O.S.

T.O.W.

TWR

TYP.

U.G.

U.N.O.

V.I.N.

WT.

SQUARE

STEEL

STANDARD

STRUCTURAL

TEMPORARY

THICK(NESS)

TOE NAIL

STAINLESS STEEL

TO BE DETERMINED

TOWER MOUNTED AMPLIFIER

TO BE RESOLVED

TOP OF ANTENNA

TOP OF FOUNDATION

TOP OF PLATE (PARAPET)

UNLESS NOTED OTHERWISE

TOP OF CURB

TOP OF STEEL

TOP OF WALL

UNDER GROUND

VERIFY IN FIELD

WEATHERPROOF


UTILITY POLE

WIDE(WIDTH)

WEIGHT

TOWER

TYPICAL

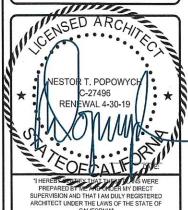

T - Mobile -

SAN DIEGO, CA 92121 T-MOBILE.COM

WIRFIESS

AC AE DESIGN GROUP, INC

5015 SHOREHAM PLACE, SUITE 150 SAN DIEGO, CA 92122

REVISIONS

90% CD's

100% CD's

CITY COMMENTS

EC

11/05/18

11/26/18

2 10/21/19

TIERRASANTA ADVENTIST SD06798A

11260 CLAIREMONT MESA BOULEVARD

SAN DIEGO, CA 92124

ABBREVIATIONS, LEGAL DESCRIPTION. REFERENCED DOCUMENTS. LEGEND & SIGNAGE

SHEET NUMBER

T-3.0


5 LEGAL DESCRIPTION

SCALE

SCALE


ABBREVIATIONS

SCALE NTS

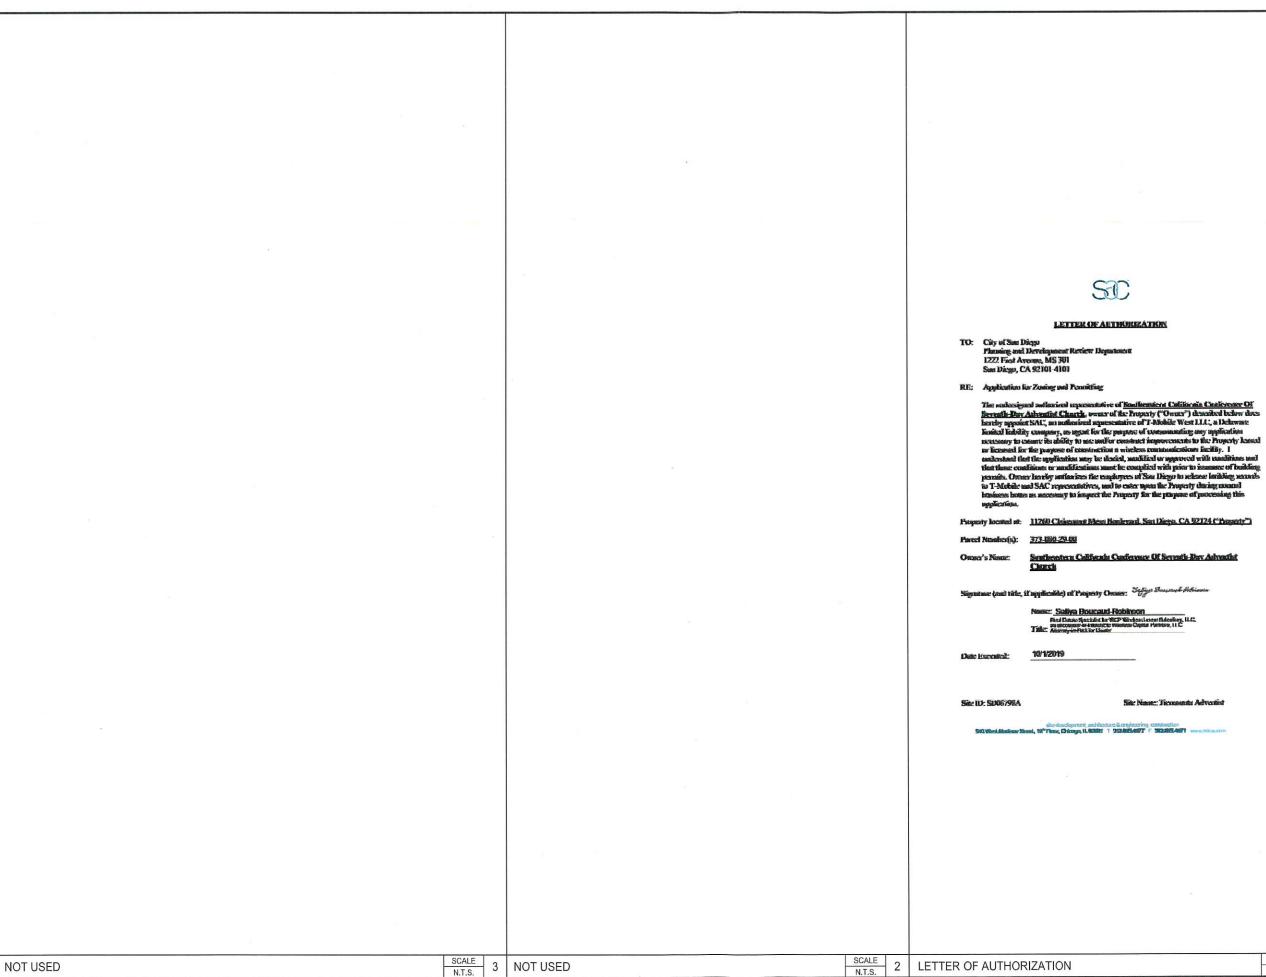





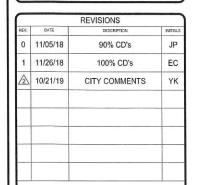



TIERRASANTA ADVENTIST SD06798A 11260 CLAIREMONT MESA BOULEVARD SAN DIEGO, CA 92124

LETTER OF AUTHORIZATION

SHEET NUMBER **△** T-4.0

SCALE 2 LETTER OF AUTHORIZATION SCALE N.T.S.

SID

LETTER OF AUTHORIZATION


Nome: Softing Boungard Foblingon


Find Dates Specialist for WID Wirefess Lesses Subselling, LLC,

Trille: Automorphism Location Control Patricto, 11 C.

Trille: Automorphism Location.


10/1/2019

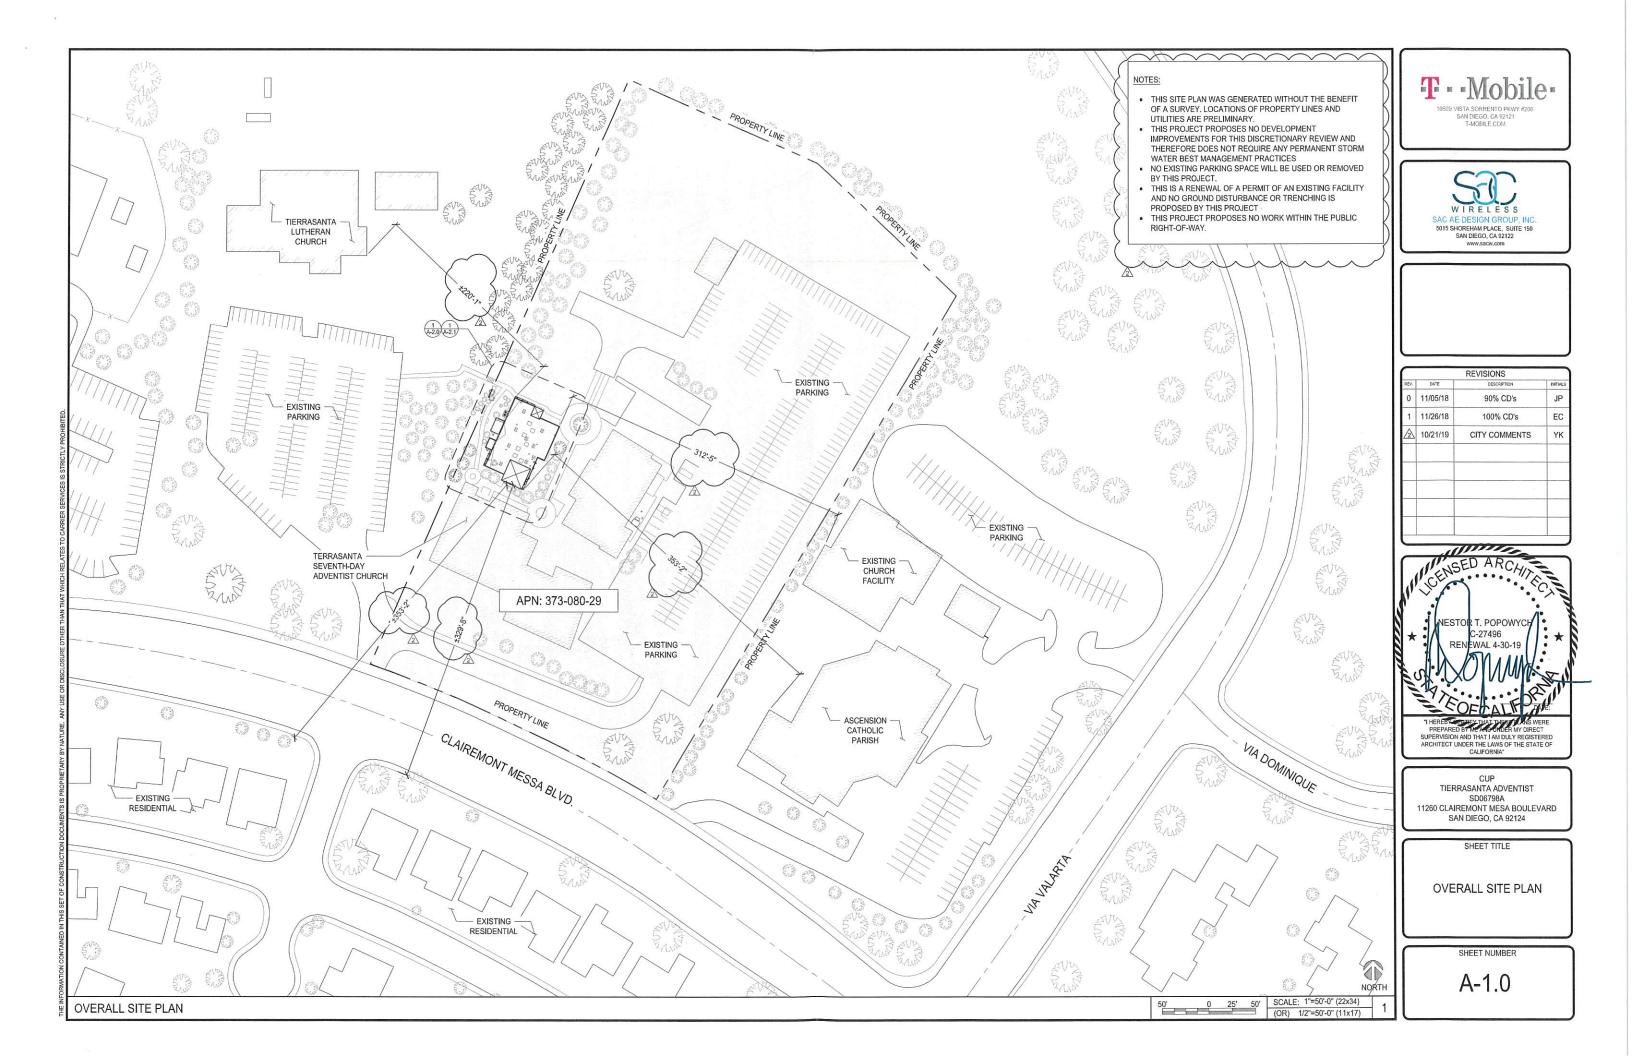


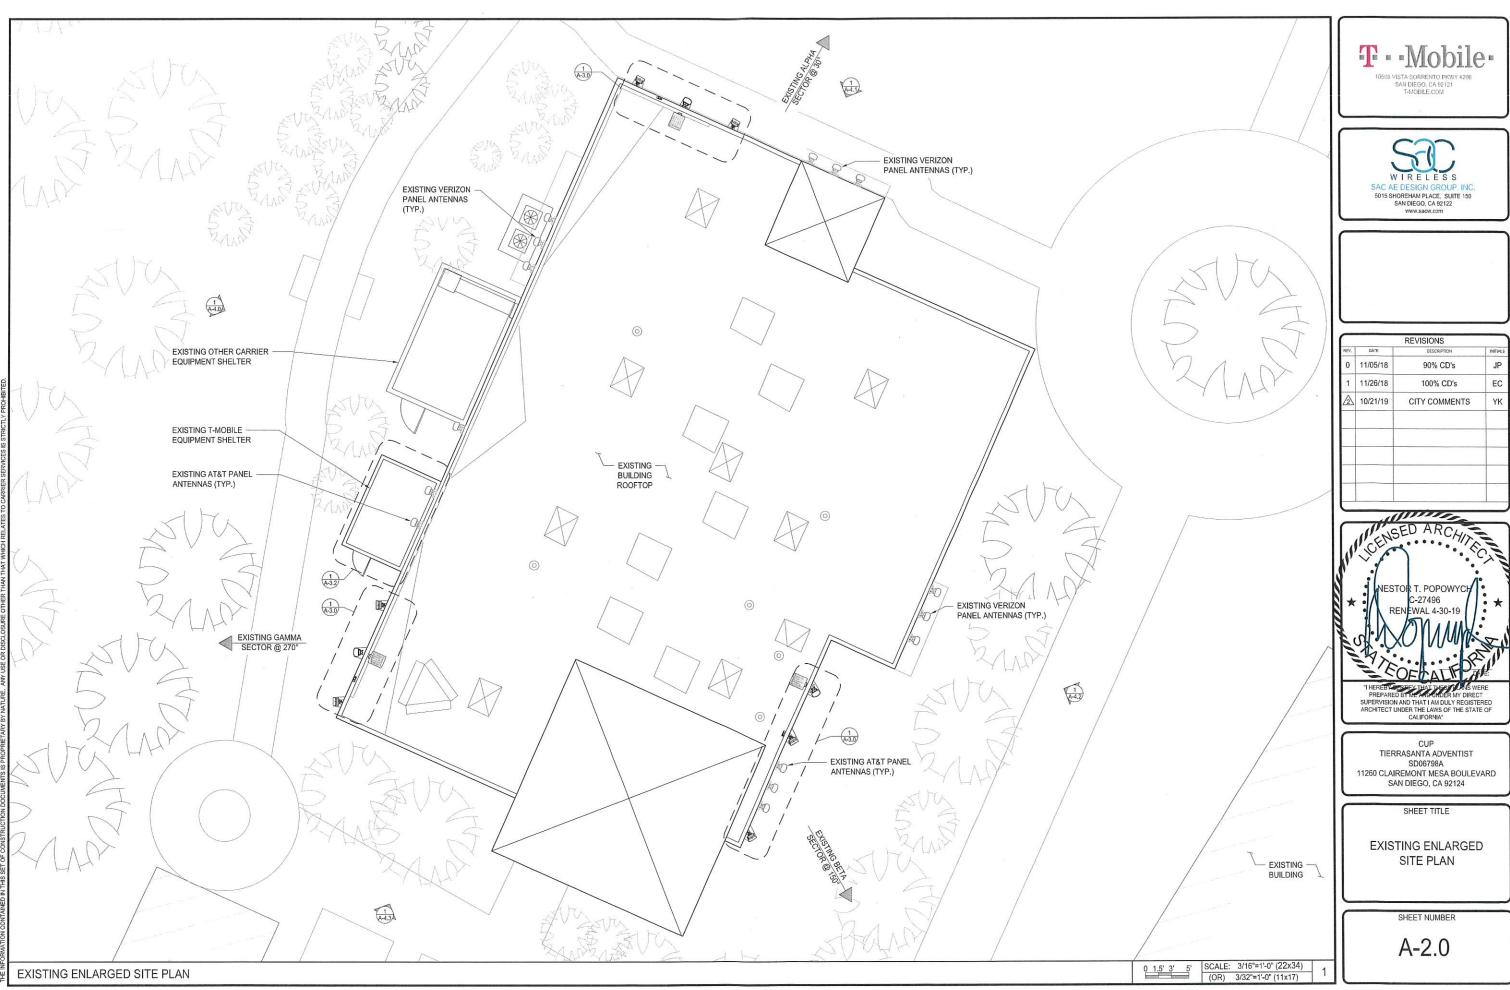

| | | REVISIONS | |
|------|----------|---------------|----------|
| REV. | DATE | DESCRIPTION | INITIALS |
| 0 | 11/05/18 | 90% CD's | JP |
| 1 | 11/26/18 | 100% CD's | EC |
| 2 | 10/21/19 | CITY COMMENTS | YK |
| | | | |
| | | | |
| | | | |
| - | | | |
| | | | |




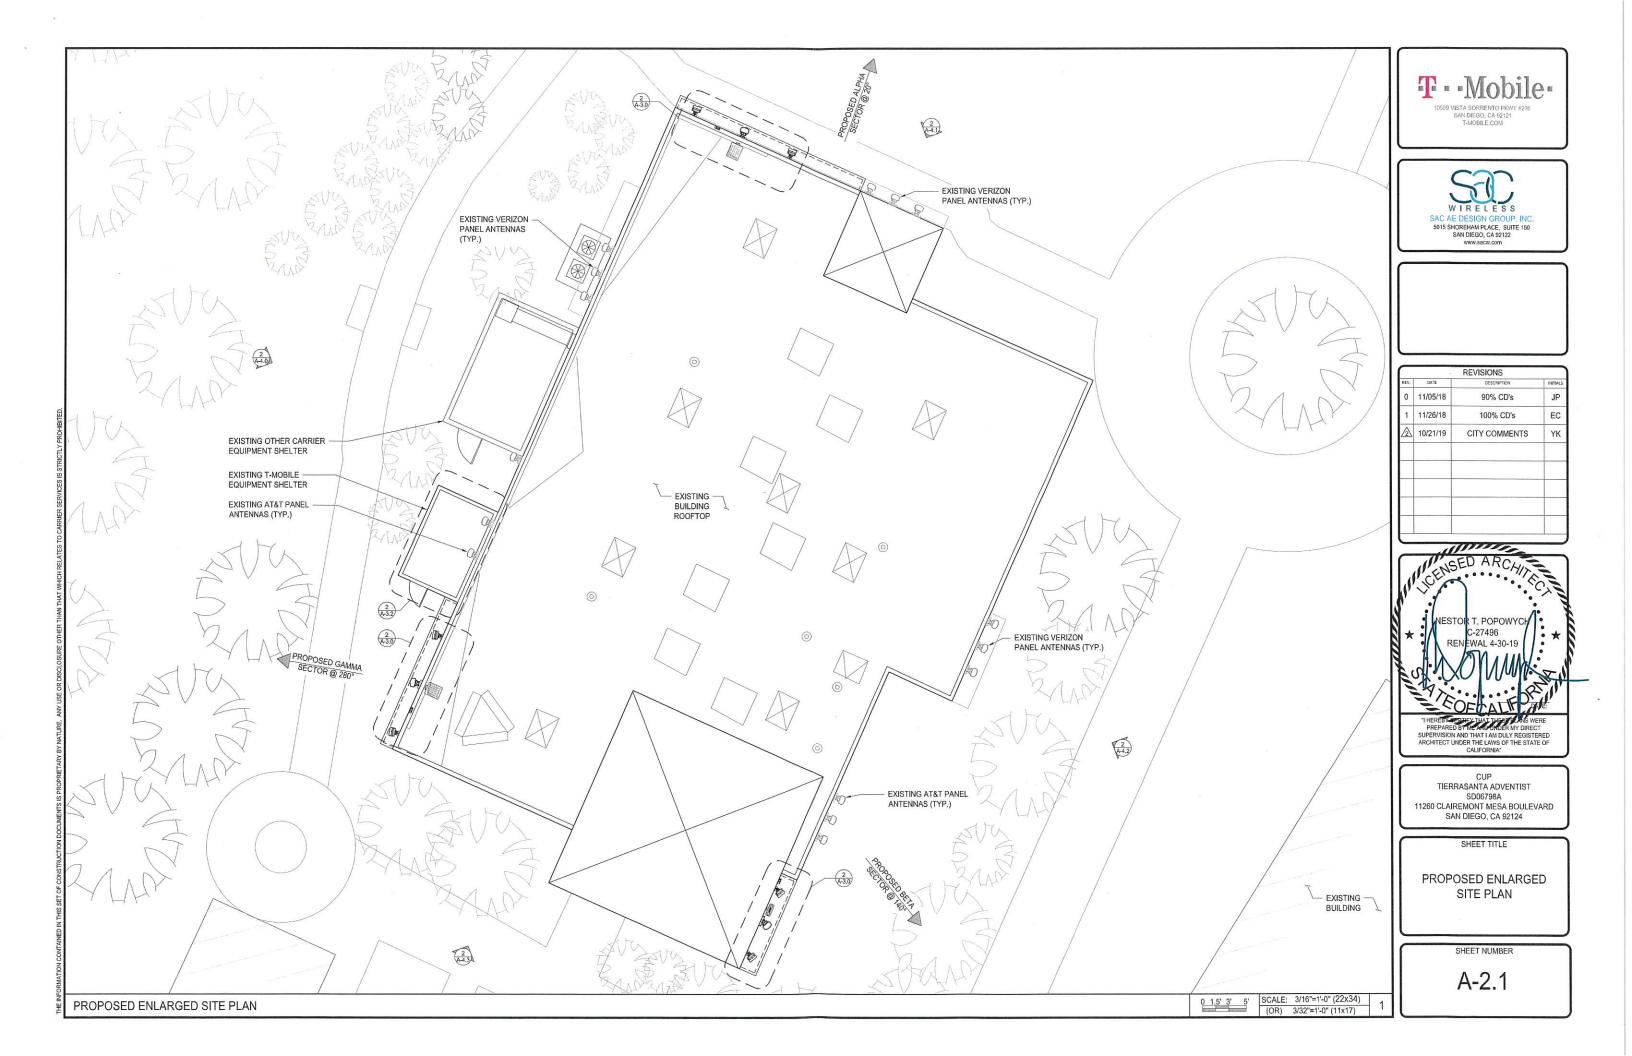

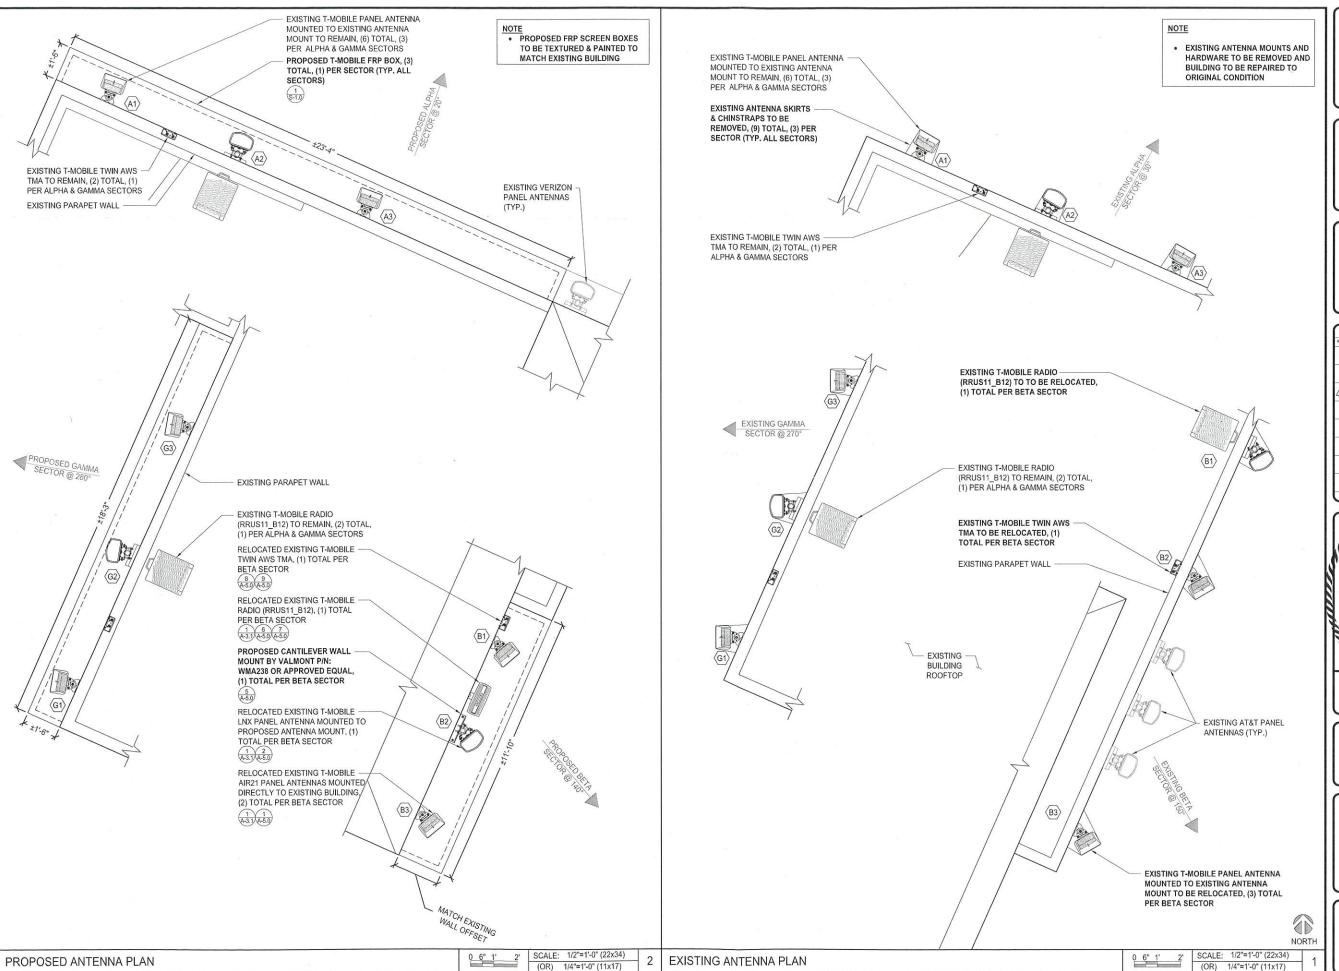





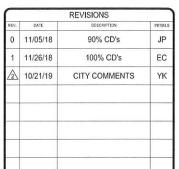




CUP TIERRASANTA ADVENTIST SD06798A 11260 CLAIREMONT MESA BOULEVARD SAN DIEGO, CA 92124

SHEET TITLE

EXISTING & PROPOSED ANTENNA PLANS

SHEET NUMBER

A-3.0

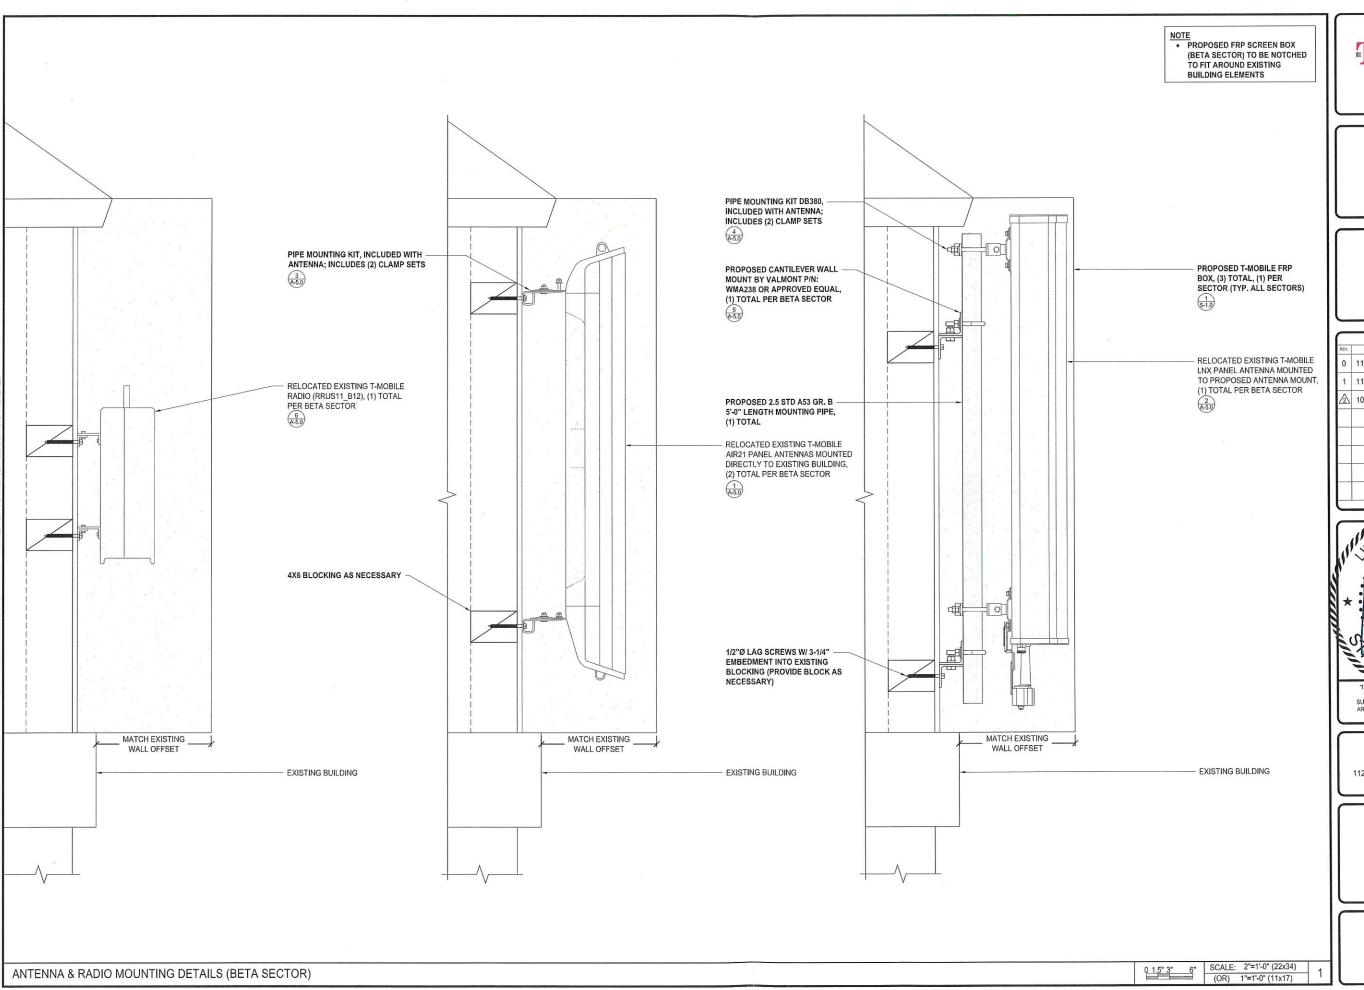





| 3 | | REVISIONS | |
|------|----------|---------------|---------|
| REV. | DATE | DESCRIPTION | INITIAL |
| 0 | 11/05/18 | 90% CD's | JP |
| 1 | 11/26/18 | 100% CD's | EC |
| 2 | 10/21/19 | CITY COMMENTS | YK |
| | | | |
| | | | |
| | | | |
| | | | |
| - | | | |



CUP TIERRASANTA ADVENTIST SD06798A 11260 CLAIREMONT MESA BOULEVARD SAN DIEGO, CA 92124

SHEET TITLE

ANTENNA & RADIO MOUNTING DETAILS (BETA SECTOR)

SHEET NUMBER

A-3.1

| | SECTOR | AZIMUTH | RAD CENTER | TOP OF ANTENNA | GENERAL ANTENNA SIZE | POSITION | EXISTING OR PROPOSED | ANTENNA MODEL | TMA/RADIO | CABLE | CABLE LENGTH AS PER RFDS | NOTE: NO NEW BATTERIES | |
|---|--------|---------|---------------|-------------------|-------------------------|----------|-----------------------|---------------------|----------------|--|-----------------------------|------------------------|--|
| | | | GLIVIEN | VIALEMAY | 4'-0" | 1 | EXISTING TO REMAIN | KRC118023-1_B2A_B4P | (1) TWIN AWS | (2) 7/8" LMU (2) 7/8" COAX (2) FIBER | 97'-0" 97'-0" 16'-0" | TO BE ADDED | |
| | | | 241.01 | 201.01 | 4'-0" | 2 | EXISTING TO REMAIN | LNX-6513DS-A1M | (1) RRUS11 B12 | (2) FIBER | 16'-0" | | |
| | ALPHA | 20° | 24'-0" | 26'-0" | 4'-0" | 3 | EXISTING TO REMAIN | KRC118023-1_B2P_B4A | N/A | (2) FIBER (1) 3X6 HCS | 16'-0" 140'/42M | | |
| | | | | | N/A | N/A | N/A | N/A | N/A | N/A | N/A | | |
| ULE | | | | | 4'-0" | 1 | RELOCATED EXISTING | LNX-6513DS-A1M | (1) RRUS11 B12 | (2) FIBER | 16'-0" | | |
| SCHEDULE | DETA | 4400 | 001.08 | 241.01 | 4'-0" | 2 | RELOCATED EXISTING | KRC118023-1_B2A_B4P | (1) TWIN AWS | (2) 7/8" LMU (2) 7/8" COAX (2) FIBER | 95'-0" 95'-0" 16'-0" | | |
| AA SC | BETA | 140° | 22'-0" | 24'-0" | 4'-0" | 3 | RELOCATED EXISTING | KRC118023-1_B2P_B4A | N/A | (1) FIBER (1) 3X6 HCS | 16'-0" 115'/35M | ¥ | |
| TEN | | | | | N/A | N/A | N/A | N/A | N/A | N/A | N/A | | |
| PROPOSED ANTENNA | | | | | 4'-0" | 1 | EXISTING TO REMAIN | KRC118023-1_B2A_B4P | (1) TWIN AWS | (2) 7/8" LMU (2) 7/8" COAX (2) FIBER | 93'-0" 93'-0" 16'-0" | | |
| SOSE | GAMMA | 2000 | 241.01 | 201.01 | 4'-0" | 2 | EXISTING TO REMAIN | LNX-6513DS-A1M | (1) RRUS11 B12 | (2) FIBER | 16'-0" | | |
| PROF | | 280° | 24'-0" | 26'-0" | 4'-0" | 3 | EXISTING TO REMAIN | KRC118023-1_B2P_B4A | N/A | (2) FIBER (1) 3X6 HCS | 16'-0" 55'/16M | | |
| | | | | | N/A | N/A | N/A | N/A | N/A | N/A | N/A | | |
| BITED. | | | | | N/A | N/A | N/A | N/A | N/A | N/A | N/A | | |
| SERVICES IS STRICTLY PROHIBITED. | DELTA | N/A | N/A | N/A | N/A | N/A | N/A | N/A | N/A | N/A | N/A | | |
| IS STRICT | DELIA | INIA | INIA | NA | IN/A | N/A | N/A | N/A | N/A | N/A | N/A | N/A | |
| SERVICES | | | | | N/A | N/A | N/A | N/A | N/A | N/A | N/A | | |
| CARRIER | | | | CONTR | ACTOR TO | REFERE | NCE FINA | L RFDS PRIOR TO | CONSTRUCTIO | N | | EXISTING BATTERY | |
| ATES TO | SECTOR | AZIMUTH | RAD CENTER | TOP OF ANTENNA | GENERAL ANTENNA SIZE | POSITION | EXISTING OR PROPOSED | ANTENNA MODEL | TMA/RADIO | CABLE | CABLE LENGTH AS PER RFDS | | |
| LOSURE OTHER THAN THAT WHICH RELATES TO | | | | | 4'-0" | 1 | EXISTING TO REMAIN | KRC118023-1_B2A_B4P | (1) TWIN AWS | (2) 7/8" LMU (2) 7/8" COAX (2) FIBER | 97'-0" 97'-0" 16'-0" | | |
| AL THAT | AI DUA | 300 | 24'-0" | 26'-0" | 4'-0" | 2 | EXISTING TO REMAIN | LNX-6513DS-A1M | (1) RRUS11B12 | (2) FIBER | 16'-0" | | |
| H | ALPHA | 30° | 24-0 | 20-0 | 4'-0" | 3 | EXISTING TO REMAIN | KRC118023-1_B2P_B4A | N/A | (2) FIBER | 16'-0" | PROPOSED EQUIP | |
| E STEEL | | | | | | | INCIVIALIA | | | | | (1) PROPOSED 66 | |

| EXISTING BATTERY SPECIF | ICATIONS |
|--|-----------|
| CABINET #1 TYPE | PBC 6500 |
| BATTERY MANUFACTURER | NORTHSTAR |
| MODEL NUMBER: | NSB100FT |
| ELECTROLYTE CONTENT PER BATTERY (IN GALLONS) | 1.2 |
| ELECTROLYTE HAZARD CLASSIFICATION PER '13 C.F.C. (8.7% SULFURIC ACID): | CORROSIVE |
| NUMBER OF BATTERIES INSTALLED | 8 |
| MAXIMUM NUMBER OF BATTERIES PER CABINET | 20 |
| TOTAL ELECTROLYTES CONTAINED IN CABINET | 9.6 |





| | | REVISIONS | |
|------|----------|---------------|----------|
| REV. | DATE | DESCRIPTION | PHITTALS |
| 0 | 11/05/18 | 90% CD's | JP |
| 1 | 11/26/18 | 100% CD's | EC |
| 2 | 10/21/19 | CITY COMMENTS | YK |
| | | | |
| | | | |
| | | | _ |
| | | | |
| | | | |



CUP TIERRASANTA ADVENTIST SD06798A 11260 CLAIREMONT MESA BOULEVARD SAN DIEGO, CA 92124


SHEET TITLE


EQUIPMENT PLANS, **EXISTING BATTERY CALCULATIONS &** ANTENNA SCHEDULE

SHEET NUMBER

A-3.2

| CONTRACTOR OF STREET | | | | | | | | | | | |
|----------------------|------------|--------------|-------------------|-------------------------|----------|-----------------------------|---------------------|---------------|--|-----------------------------|---|
| | | | CONTRA | CTOR TO | REFERE | NCE FINA | L RFDS PRIOR TO | CONSTRUCTION | | | EXISTING BATTERY CALCULATIONS SCALE N.T.S. 2 |
| SECTO | OR AZIMUTH | H RAD CENTER | TOP OF ANTENNA | GENERAL ANTENNA SIZE | POSITION | EXISTING OR PROPOSED | ANTENNA MODEL | TMA/RADIO | CABLE | CABLE LENGTH AS PER RFDS | 10'-6" |
| | | | | 4'-0" | 1 | EXISTING TO REMAIN | KRC118023-1_B2A_B4P | (1) TWIN AWS | (2) 7/8" LMU (2) 7/8" COAX (2) FIBER | 97'-0" 97'-0" 16'-0" | |
| AL DU | A 30° | 24'-0" | 26'-0" | 4'-0" | 2 | EXISTING TO REMAIN | LNX-6513DS-A1M | (1) RRUS11B12 | (2) FIBER | 16'-0" | EXISTING HVAC UNITS (TYP. OF 2) |
| ALPH | A 30 | 24-0 | 26-0 | 4'-0" | 3 | EXISTING TO REMAIN | KRC118023-1_B2P_B4A | N/A | (2) FIBER | 16'-0" | PROPOSED EQUIPMENT INSIDE EXISTING EQUIPMENT CABINET: (1) PROPOSED 6601 |
| | | | | N/A | N/A | N/A | N/A | N/A | N/A | N/A | (1) PROPOSED XMU03 |
| 9 | 47 | | | 4'-0" | 1 | EXISTING TO BE RELOCATED | LNX-6513DS-A1M | (1) RRUS11B12 | (2) FIBER | 16'-0" | EXISTING T-MOBILE EQUIPMENT — EXISTING T-MOBILE PBC6500 BATTERY CABINET CABINET (TYP, OF 2) |
| SCHEDULE | 4500 | 221.01 | 241011 | 4'-0" | 2 | EXISTING TO BE RELOCATED | KRC118023-1_B2A_B4P | (1) TWIN AWS | (2) 7/8" LMU (2) 7/8" COAX (2) FIBER | 95'-0" 95'-0" 16'-0" | |
| | 150° | 22'-0" | 24'-0" - | 4'-0" | 3 | EXISTING TO BE RELOCATED | KRC118023-1_B2P_B4A | N/A | (1) FIBER | 16'-0" | EXISTING T-MOBILE EQUIPMENT SHELTER (±135 SQ. FT) |
| ANTENNA | | | | N/A | N/A | N/A | N/A | N/A | N/A | N/A | EXISTING T-MOBILE CIENA CABINET |
| ANT | | | | 4'-0" | 1 | EXISTING TO REMAIN | KRC118023-1_B2A_B4P | (1) TWIN AWS | (2) 7/8" LMU (2) 7/8" COAX (2) FIBER | 93'-0" 93'-0" 16'-0" | |
| GAMM | 14 2709 | 24! 0" | 20101 | 4'-0" | 2 | EXISTING TO REMAIN | LNX-6513DS-A1M | (1) RRUS11B12 | (2) FIBER | 16'-0" | EXISTING T-MOBILE 19" ——————————————————————————————————— |
| GAMN | IA 270° | 24'-0" | 26'-0" | 4'-0" | 3 | EXISTING TO REMAIN | KRC118023-1_B2P_B4A | N/A | (2) FIBER | 16'-0" | |
| | | | | N/A | N/A | N/A | N/A | N/A | N/A | N/A | |
| | | | | N/A | N/A | N/A | N/A | N/A | N/A | N/A | |
| DELT | A N/A | N/A | N/A | N/A | N/A | N/A | N/A | N/A | N/A | N/A | EXISTING ELECTRICAL PANEL |
| DELT | A N/A | N/A | N/A | N/A | N/A | N/A | N/A | N/A | N/A | N/A | EXISTING TRANSFER SWITCH |
| | | | | N/A | N/A | N/A | N/A | N/A | N/A | N/A | NORTH |
| PROPO | SED & EX | XISTING A | ANTENN | A SCHEDUL | ES. | | - | | | SCALE N.T.S. 3 | EQUIPMENT PLAN 0 6" 1' 2' SCALE: 1/2"=1"-0" (22x34) (OR) 1/4"=1"-0" (11x17) 1 |

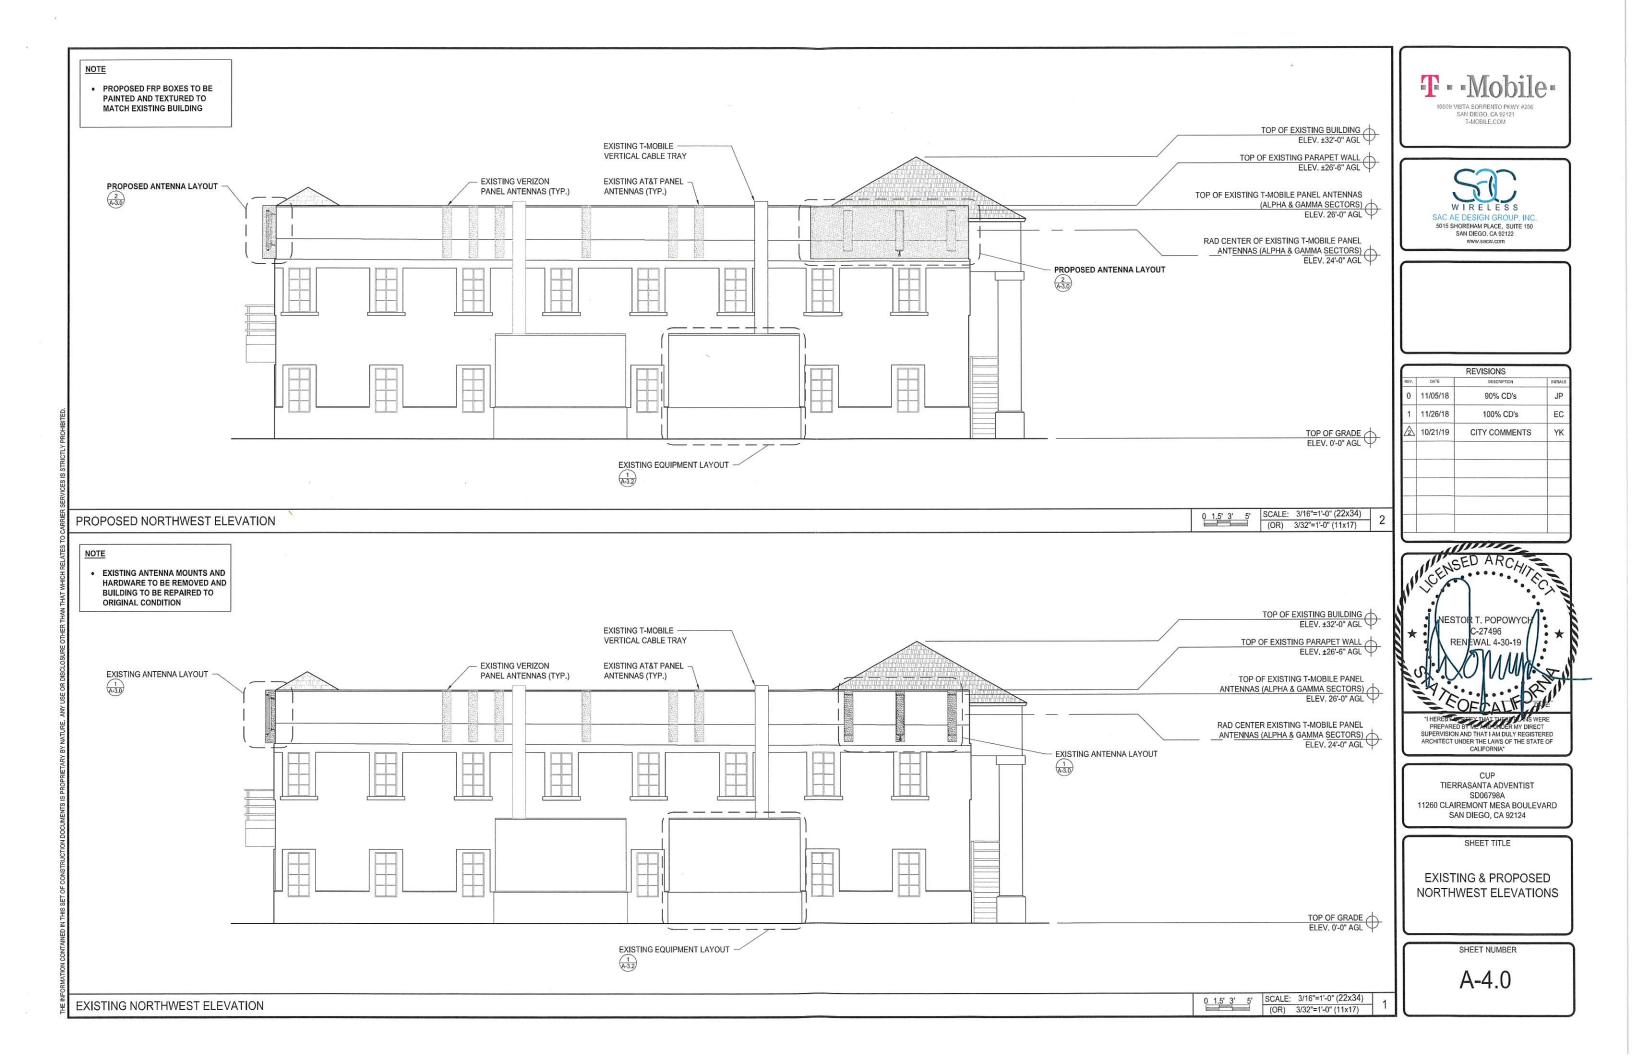

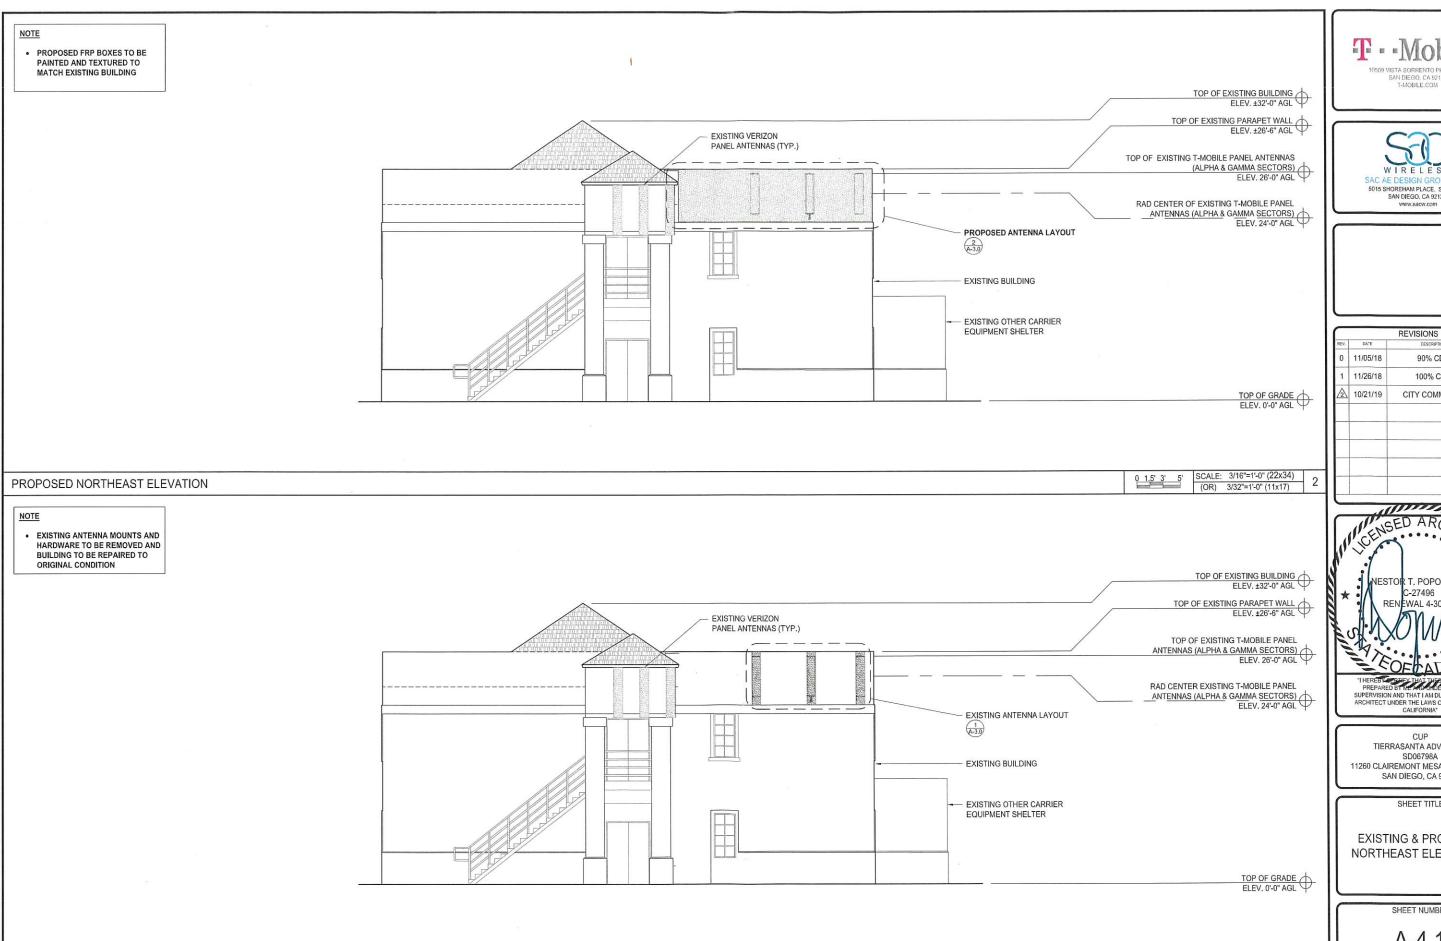

EXISTING NORTHEAST ELEVATION



REVISIONS 90% CD's EC 100% CD's CITY COMMENTS




TIERRASANTA ADVENTIST SD06798A 11260 CLAIREMONT MESA BOULEVARD SAN DIEGO, CA 92124


EXISTING & PROPOSED NORTHEAST ELEVATIONS


SHEET NUMBER


A-4.1


SCALE: 3/16"=1'-0" (22x34)

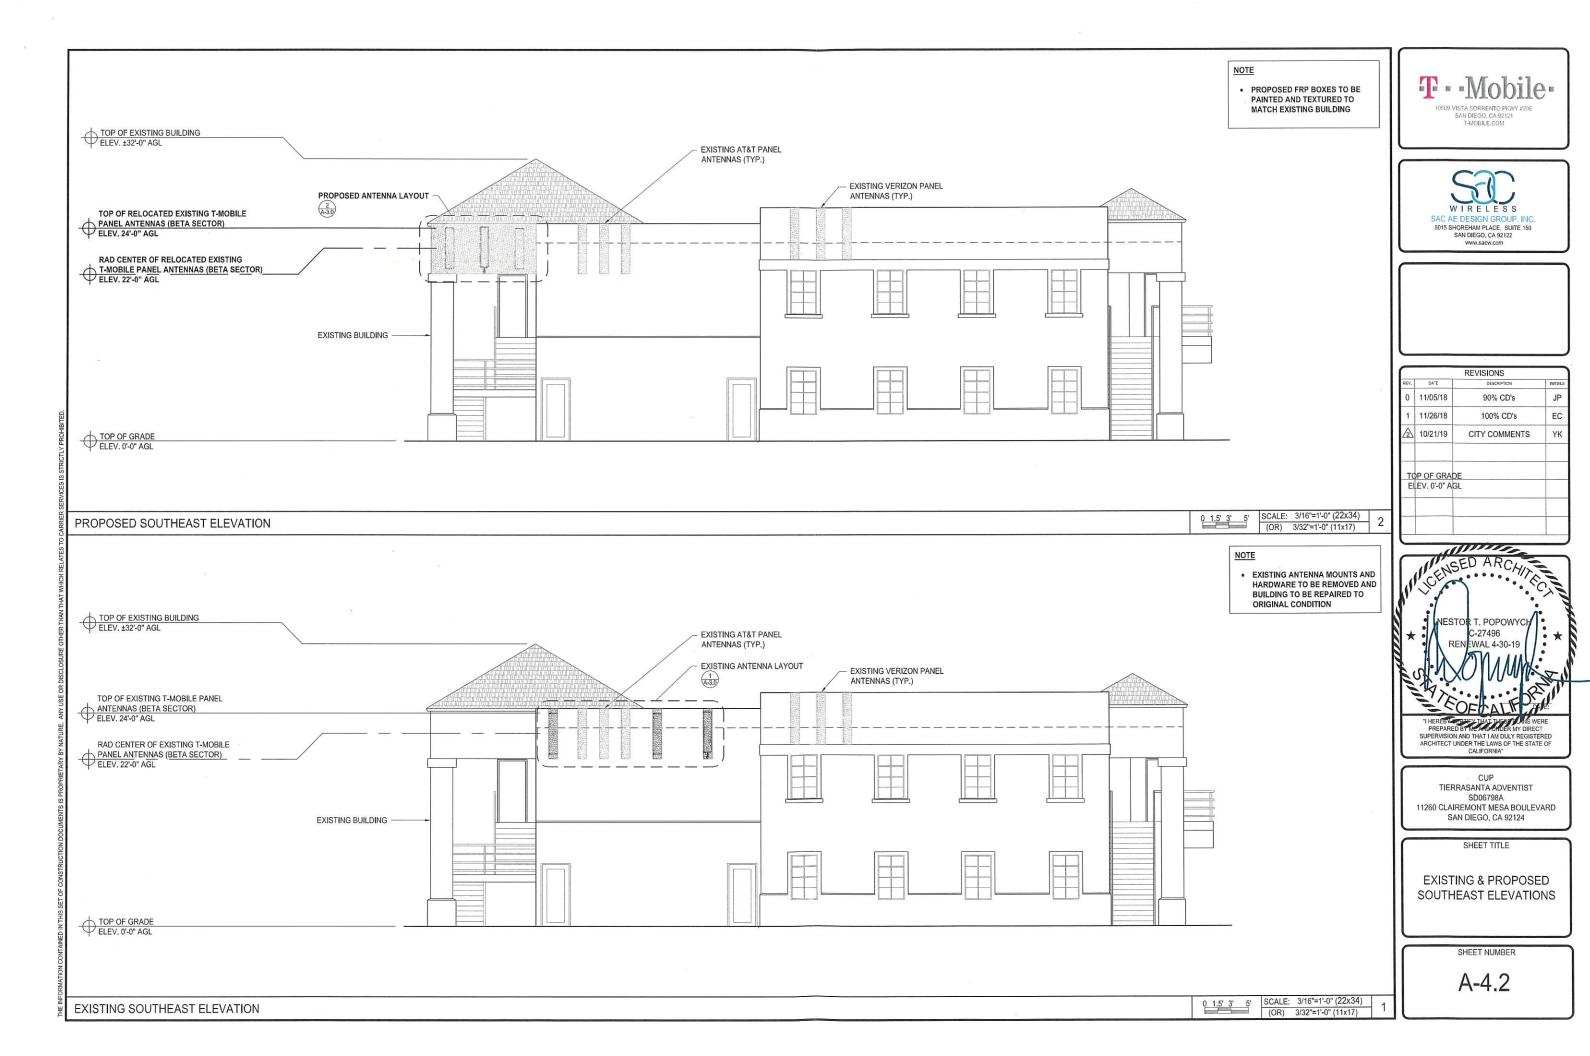

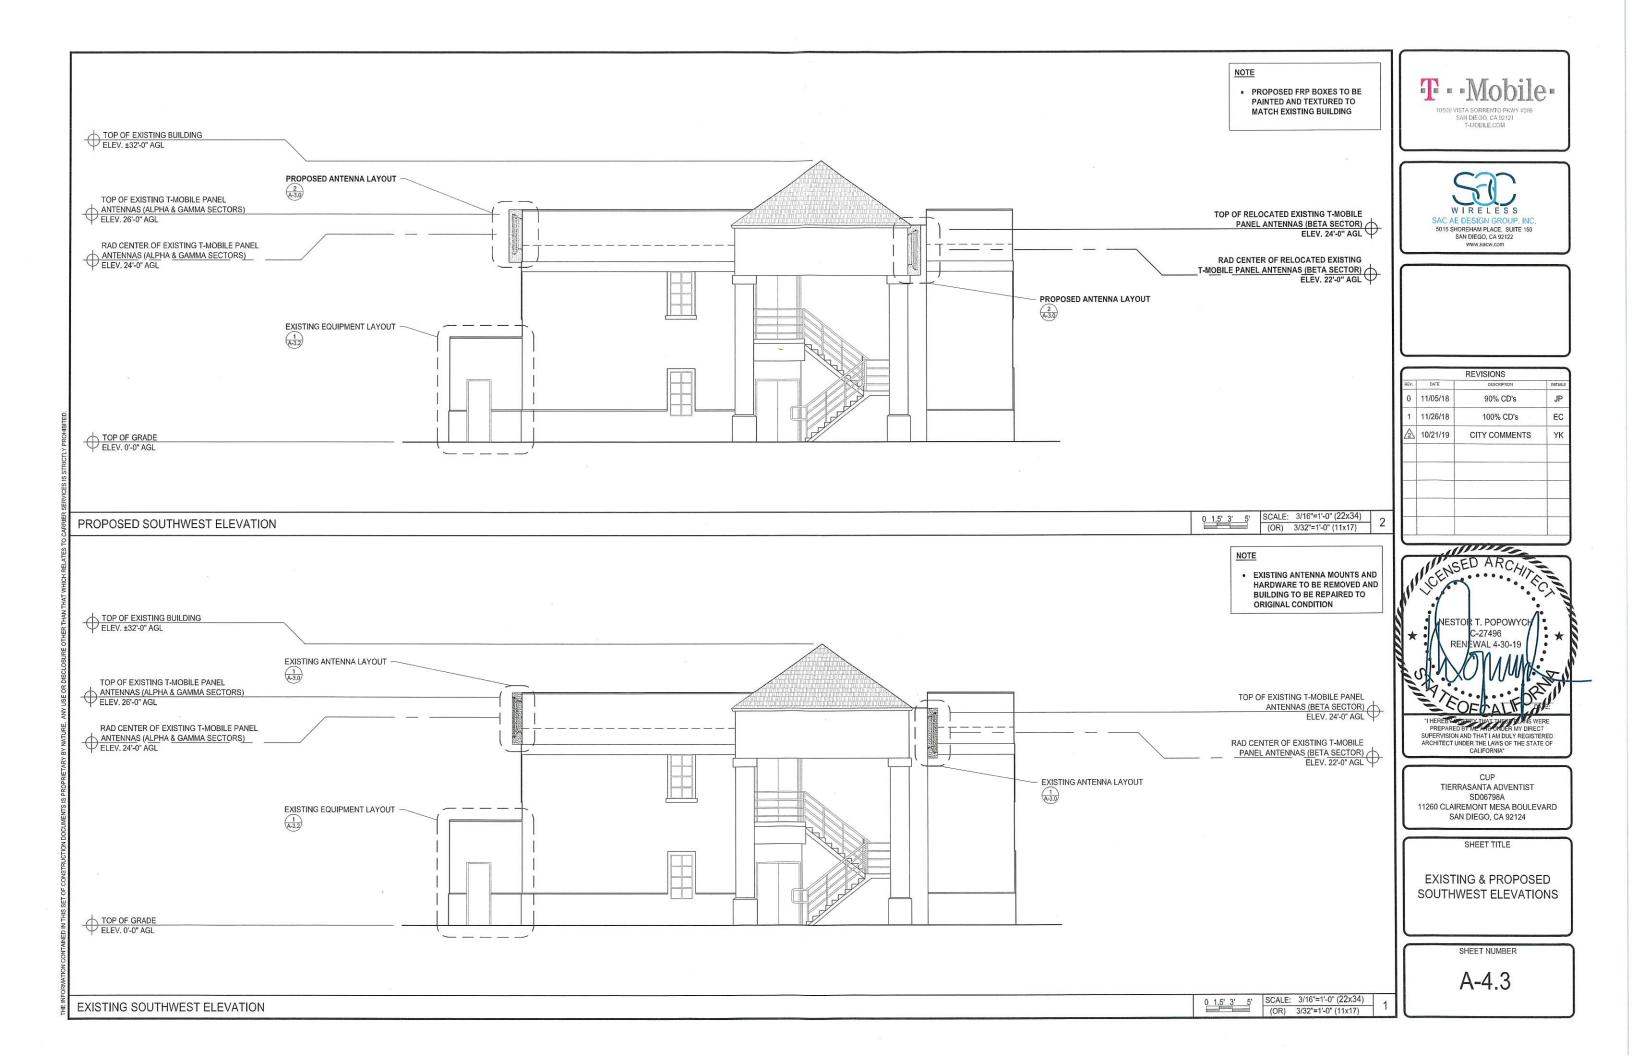

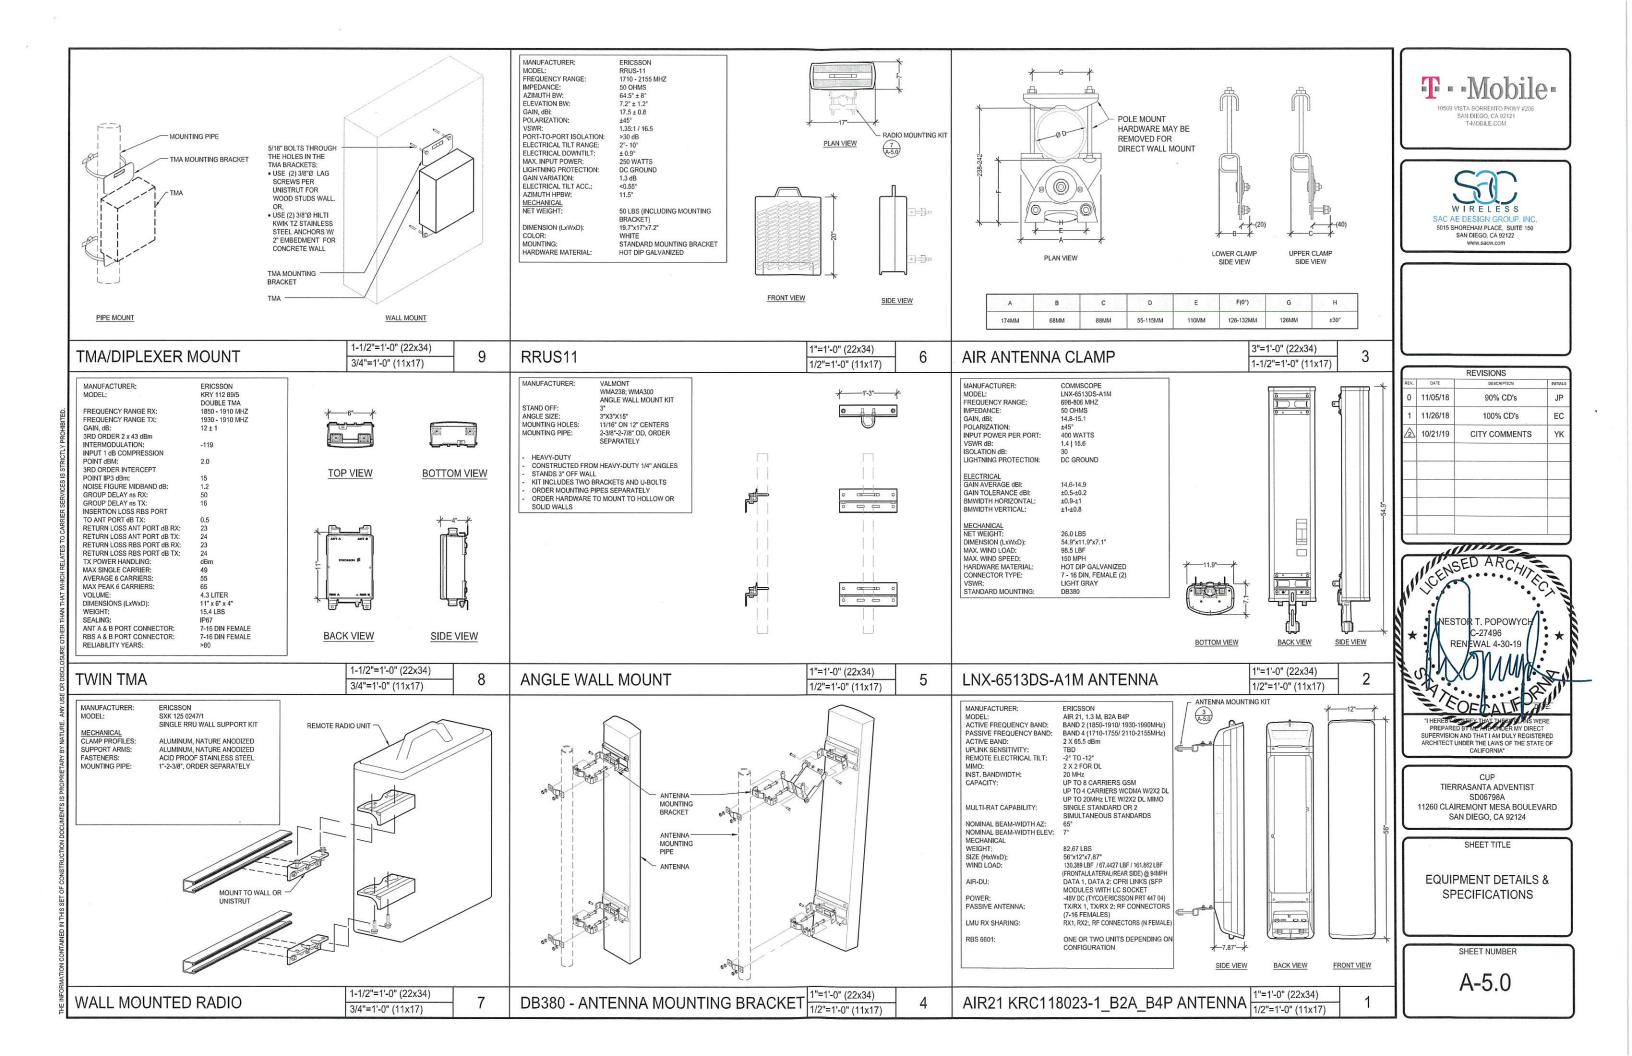

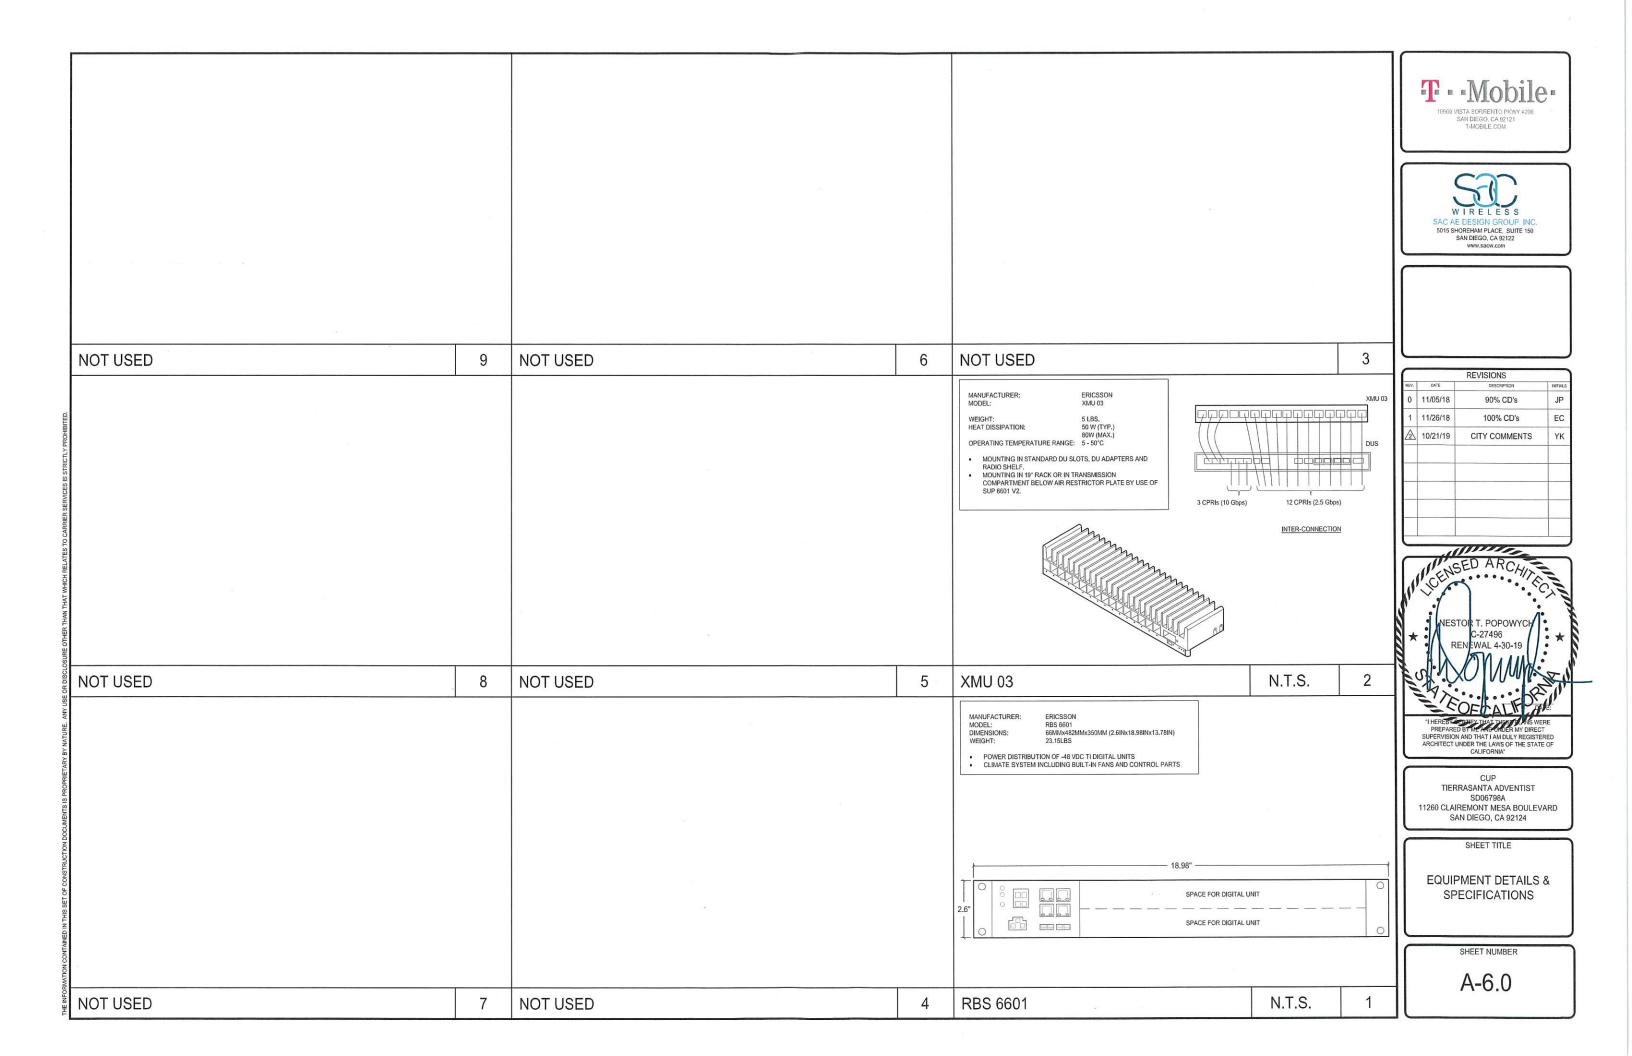


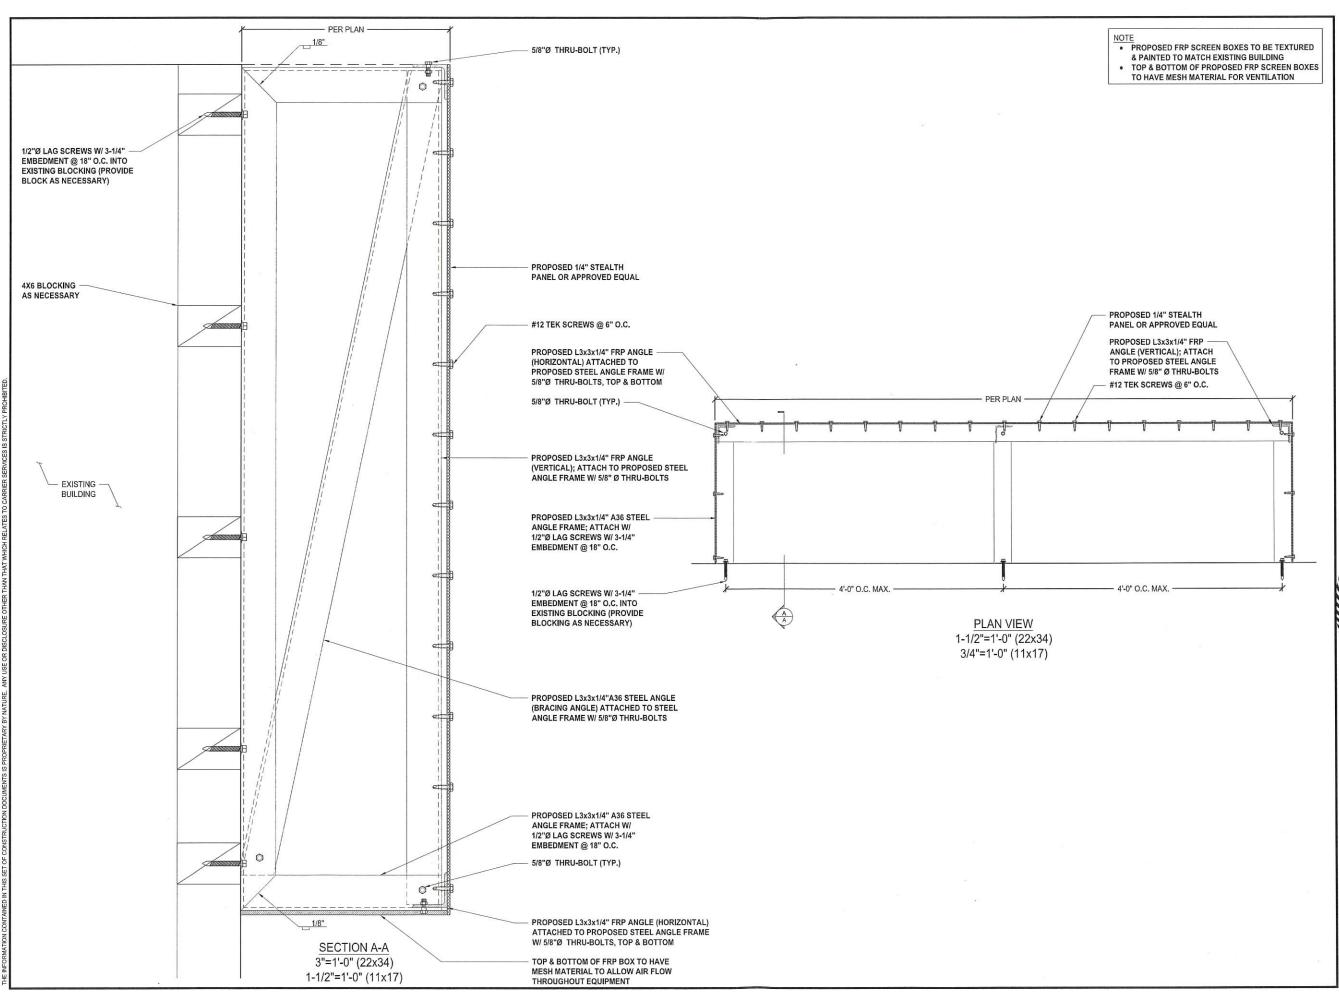





| 8 | | REVISIONS | |
|------|----------|---------------|----------|
| REV. | DATE | DESCRIPTION | INITIALS |
| 0 | 11/05/18 | 90% CD's | JP |
| 1 | 11/26/18 | 100% CD's | EC |
| 2 | 10/21/19 | CITY COMMENTS | YK |
| | | | |
| | | | |
| | | | |
| | | | |
| | | | |

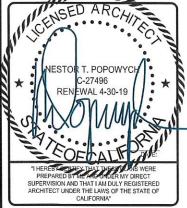


CUP TIERRASANTA ADVENTIST SD06798A 11260 CLAIREMONT MESA BOULEVARD SAN DIEGO, CA 92124


SHEET TITLE

STRUCTURAL DETAILS

SHEET NUMBER

S-1.0

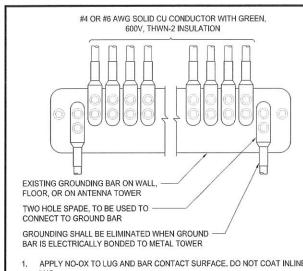

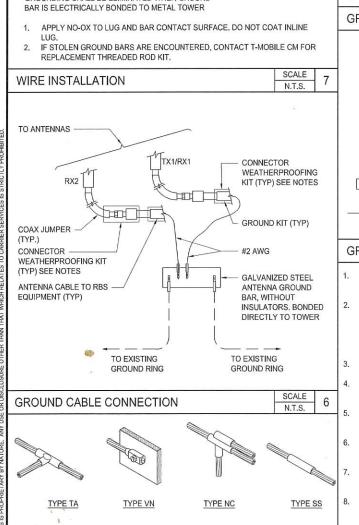

TYPE VB

TYPE W

TYPE PT

TYPE VS

EXOTHERMIC WELD CONNECTIONS

TYPE GT

TYPE GR

TYPE GY

TYPE GL

SCALE

N.T.S.

- PROPOSED ANTENNA GROUND BUS BAR NEAR ANTENNA MOUNTS WITH COAX GROUND KIT. SEE DETAIL 6/G-1.
- PROPOSED #6 AWG GROUND FROM ANTENNA GROUND BUS BAR TO TIE INTO PROPUSED #6 AWG GROUND FINANT AND EXECUTION OF (2) PLACES). SEE DETAIL 7/G-1.
- PROPOSED #6 AWG GROUND FROM EQUIPMENT MOUNT TO ANTENNA GROUND BUS BAR. SEE DETAIL 5/G-1.
- PROPUSED #6 A...
 SEE DETAIL 6/G-1. PROPOSED #6 AWG GROUND FROM ANTENNAS TO ANTENNA GROUND BUS BAR.
- PROPOSED #6 AWG GROUND FROM RADIOS/TMAS TO ANTENNA GROUND BUS
- N/A: EXISTING EQUIPMENT GROUND BUS BAR NEAR EQUIPMENT WITH COAX 6) GROUND KIT. SEE DETAIL 7/G-1.
- N/A: #6 AWG GROUND BATTERY CABINET TO EQUIPMENT GROUND BUSS BAR. SEE DETAIL 7/G-1.
- 8 N/A; EXISTING #6 AWG GROUND FROM EXISTING EQUIPMENT GROUND BUS BAR TO TIE INTO EXISTING GROUNDING SYSTEM (TYP OF (2) PLACES). SEE DETAIL 7/G-1.

| ROUNDING | KEY | N.T.S. | 4 |
|-----------|-------------------|--------|---|
| \otimes | COPPER GROUND ROD | | |

SCALE

|----------------------------------|---|
| | MECHANICAL CONNECTION |
| | CADWELD CONNECTION |
| | FIELD VERIFY & TIE INTO EXISTING GROUNDING SYSTEM |
| | TEST WELL |
| 00 00 00 00 00 00 00 00 00 00 | GROUND BAR |
| ————G——— | GROUNDING WIRE |

| CDOLINDING LECEND | SCALE N.T.S. | 2 |
|-------------------|-----------------|---|
| GROUNDING LEGEND | N.T.S. | 3 |


- ALL DETAILS ARE SHOWN IN GENERAL TERMS. ACTUAL INSTALLATION AND CONSTRUCTION MAY VARY DUE TO SITE SPECIFIC CONDITIONS.
- GROUND ALL ANTENNA BASES, FRAMES, CABLE RUNS, AND OTHER METALLIC COMPONENTS USING GROUND WIRES AND CONNECT TO SURFACE MOUNTED BUS BARS, FOLLOW ANTENNA AND BTS MANUFACTURES PRACTICES FOR GROUNDING REQUIREMENTS. GROUND COAX SHIELDS AT BOTH ENDS AND EXIT FROM TOWER OR POLE USING MFR'S PRACTICES.
- ALL GROUND WIRE SHALL BE GREEN INSULATED WIRE ABOVE GROUND.
- CONTRACTOR TO VERIFY AND TEST GROUND TO SOURCE, GROUNDING AND OTHER OPERATIONAL TESTING WILL BE WITNESSED BY A T-MOBILE REPRESENTATIVE.
- REFER TO DIVISION 16 GENERAL ELECTRIC: GENERAL ELECTRICAL PROVISION AND COMPLY WITH ALL REQUIREMENTS OF GROUNDING STANDARDS.
- CONTRACTOR TO ABIDE BY ALL T-MOBILE SAFETY STANDARDS DURING SITE
- CONTRACTOR SHALL REFER TO T-MOBILE STANDARDS FOR GROUNDING
- ELECTRICAL CONTRACTOR TO PROVIDE DETAILED DESIGN OF GROUNDING SYSTEM, AND RECEIVE APPROVAL OF DESIGN BY AUTHORIZED T-MOBILE REPRESENTATIVE, PRIOR TO INSTALLATION OF GROUNDING SYSTEM. PHOTO DOCUMENT ALL CADWELDS AND GROUND RING.
- NOTIFY CONSTRUCTION MANAGER IF THERE ARE ANY DIFFICULTIES INSTALLING GROUNDING SYSTEM DUE TO SITE SOIL CONDITIONS.
- 10. GROUNDING ROD NOTES (WHERE APPLICABLE)

GENERAL GROUNDING NOTES

- 11. FLECTRICAL CONTRACTOR SHALL ORDER GROUND RESISTANCE TESTING ONCE THE GROUND SYSTEM HAS BEEN INSTALLED: A QUALIFIED INDIVIDUAL. UTILIZING THE FALL OF POTENTIAL METHOD, SHOULD PERFORM THE TEST. THE REPORT WILL SHOW THE LOCATION OF THE TEST AND CONTAIN NO LESS THAN 9 TEST POINTS ALONG THE TESTING LINE, GRAPHED OUT TO SHOW THE PLATEAU.
- 12. POINT GROUND TEST OR 3 POINT 62% TESTS WILL NOT BE ACCEPTED AS ALTERNATIVES TO THE AFORE MENTIONED GROUND TESTS. TEST SHALL BE PERFORMED WHILE THE COUNTERPOISE IS ISOLATED. TEST SHALL BE PERFORMED WHILE THE COUNTERPOISE IS ISOLATED FROM THE A/C SYSTEM GRIDS AND EXISTING COMMUNICATIONS FACILITY.


SCALE

NTS

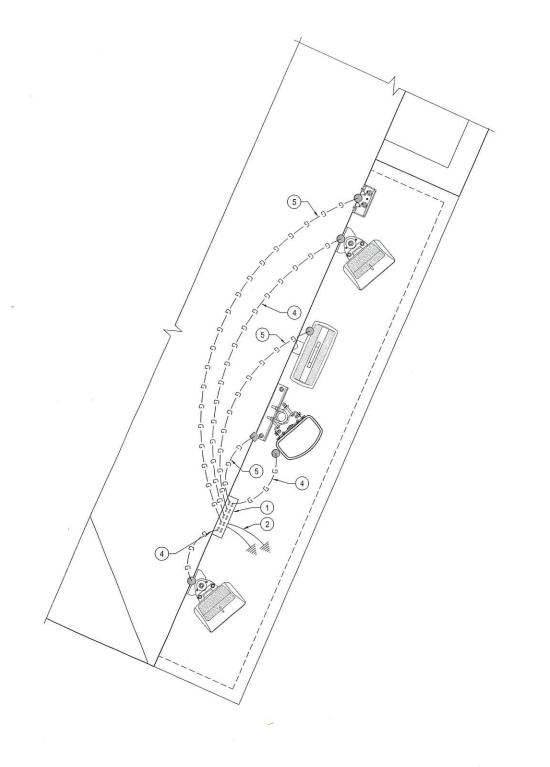





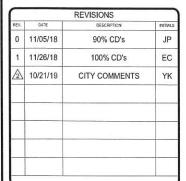



TIERRASANTA ADVENTIST SD06798A 11260 CLAIREMONT MESA BOULEVARD SAN DIEGO, CA 92124

SHEET TITLE

SCHEMATIC GROUNDING PLANS, NOTES & DETAILS

SHEET NUMBER

G-1.0

SCALE: 1"=1'-0" (22x34)

(OR) 1/2"=1'-0" (11x17)

SCHEMATIC ANTENNA GROUNDING PLAN